

SECTION 1
N.T.S.
TYPICAL INTERFACE AT
REAR OF LOT (HEIGHT < 2.0m)

LEGEND

- AREAS OF FILL
- 18.70 FINISHED SURFACE LEVEL
- 18.68 NATURAL SURFACE LEVEL
- FALL OF LOTS
- RETAINING WALL
- DESIGN SURFACE CONTOURS (0.2m INTERVAL)
- EXISTING SURFACE CONTOURS (0.2m INTERVAL)
- EXISTING STORMWATER DRAINAGE
- EXISTING ELECTRICAL
- EXISTING SEWERAGE
- EXISTING WATER
- EXISTING COMMS (NBN)
- EXISTING RETAINING WALL

AS CONSTRUCTED INFORMATION
CERTIFIED BY AKJ SERVICES

SIGNED DAVID WARD DATE 15/11/24

WARNING

BWARE OF SERVICES
The locations of all existing services are approximate only and their exact position should be proven on site. No guarantee is given that all existing services are shown.


PERMISSION TO USE FOR CONSTRUCTION PURPOSES
ROADWORKS AND STORMWATER DRAINAGE.

SIGNED NADINE NILON DATE 23.01.24

DIRECTOR OF CITY GROWTH AND OPERATIONS
CITY OF PALMERSTON
This permission to use is given on the basis that the Developer and/or Consultant is not absolved from full responsibility for the correctness and accuracy of the design and/or documents associated. This permission is valid for a period of two years from the date of signed approval.

SCALE 1:500 (A1)
1:1000 (A3) 0 10 20 30 40 50m
10 8 6 4 2

AS CONSTRUCTED

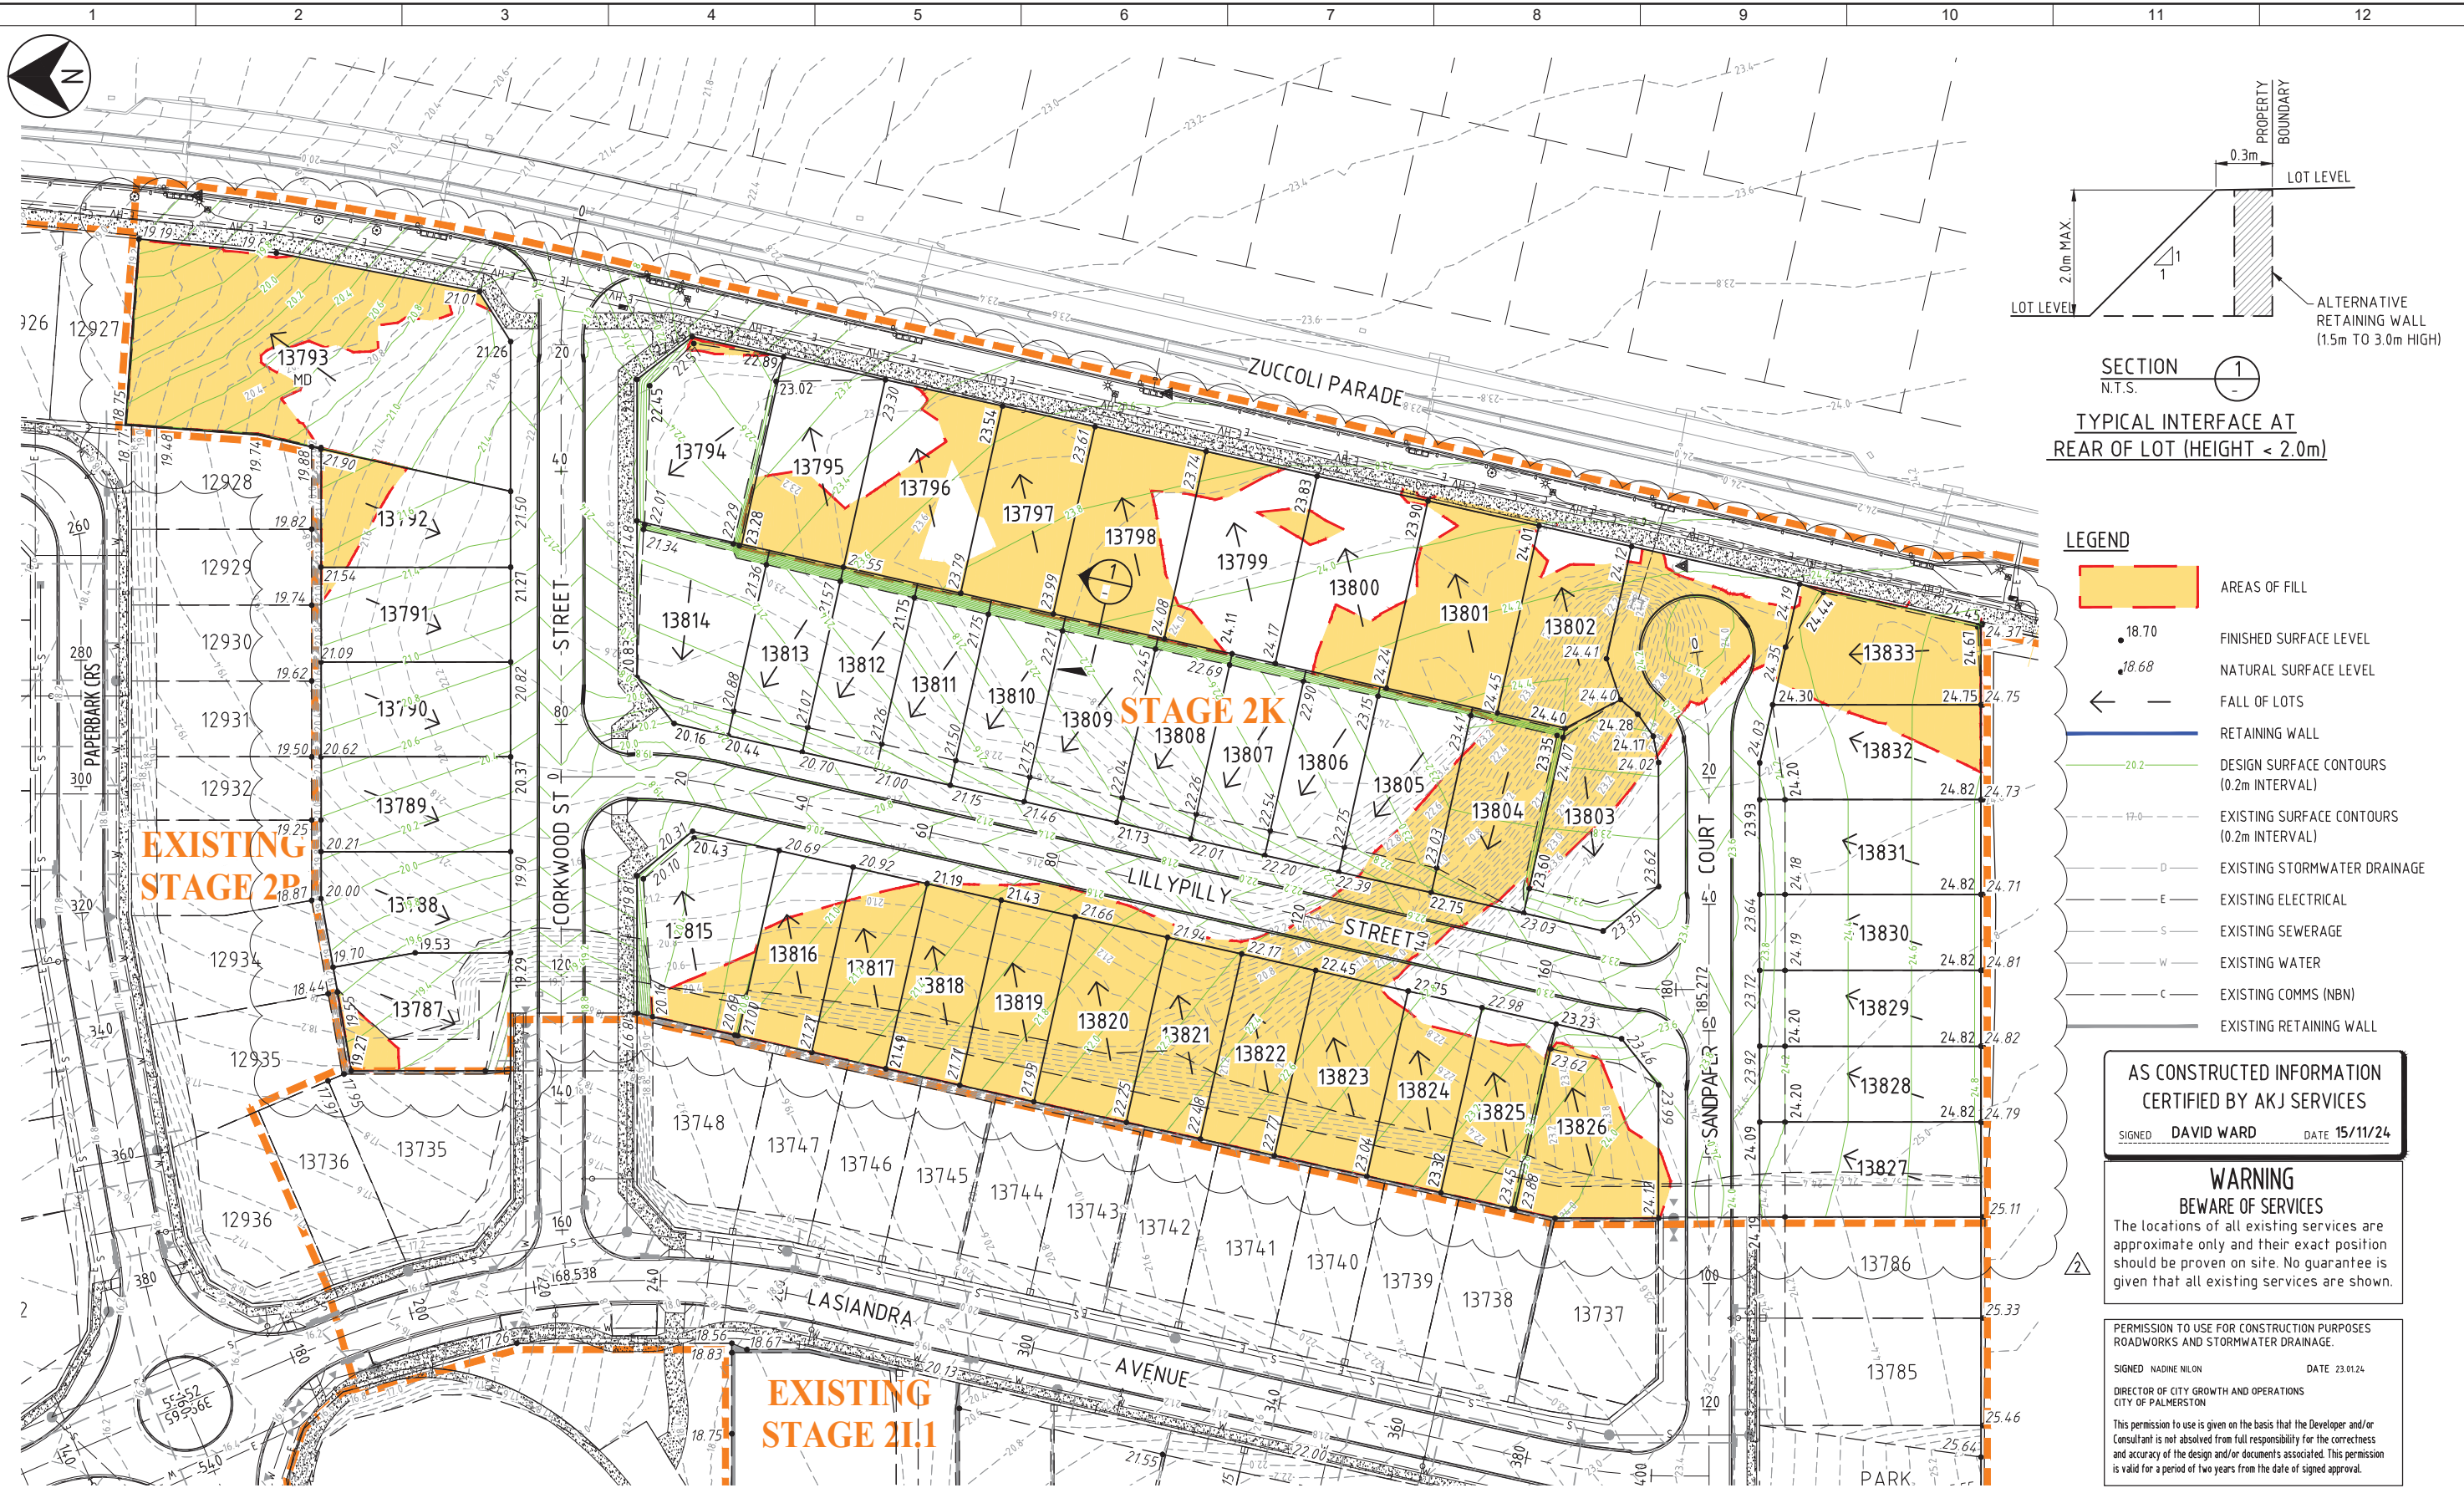

REV	DATE	DRAWN	REV'D	APP'D	REVISION
2	15.11.24	TAB	TG	RK	AS CONSTRUCTED
1	26.04.24	TAB	TG	RK	EARTHWORKS REVISED
0	30.01.24	TAB	TG	RK	ISSUED FOR CONSTRUCTION



CLIENT TERRITORY LIFE		REVIEWED T.GAETAN		APPROVED R.KRAKE	
PROJECT MITCHELL CREEK GREEN STAGE 2K		DESIGNED TAB		DATE 07.03.23	
DRAWN TG		DESIGN REVIEW RK		DATE 07.03.23	

TITLE BULK EARTHWORKS PLAN		
SCALE AS SHOWN	DRAWING No IW178402-00-CI-DRG-0209	REV 2

DATE: 29/11/2024 3:16:29 PM LOGIN NAME: LOCATION: C:\Users\jgaetant\AppData\Local\Temp\proj\ci\dwg\ci\DRG-0209.dwg