

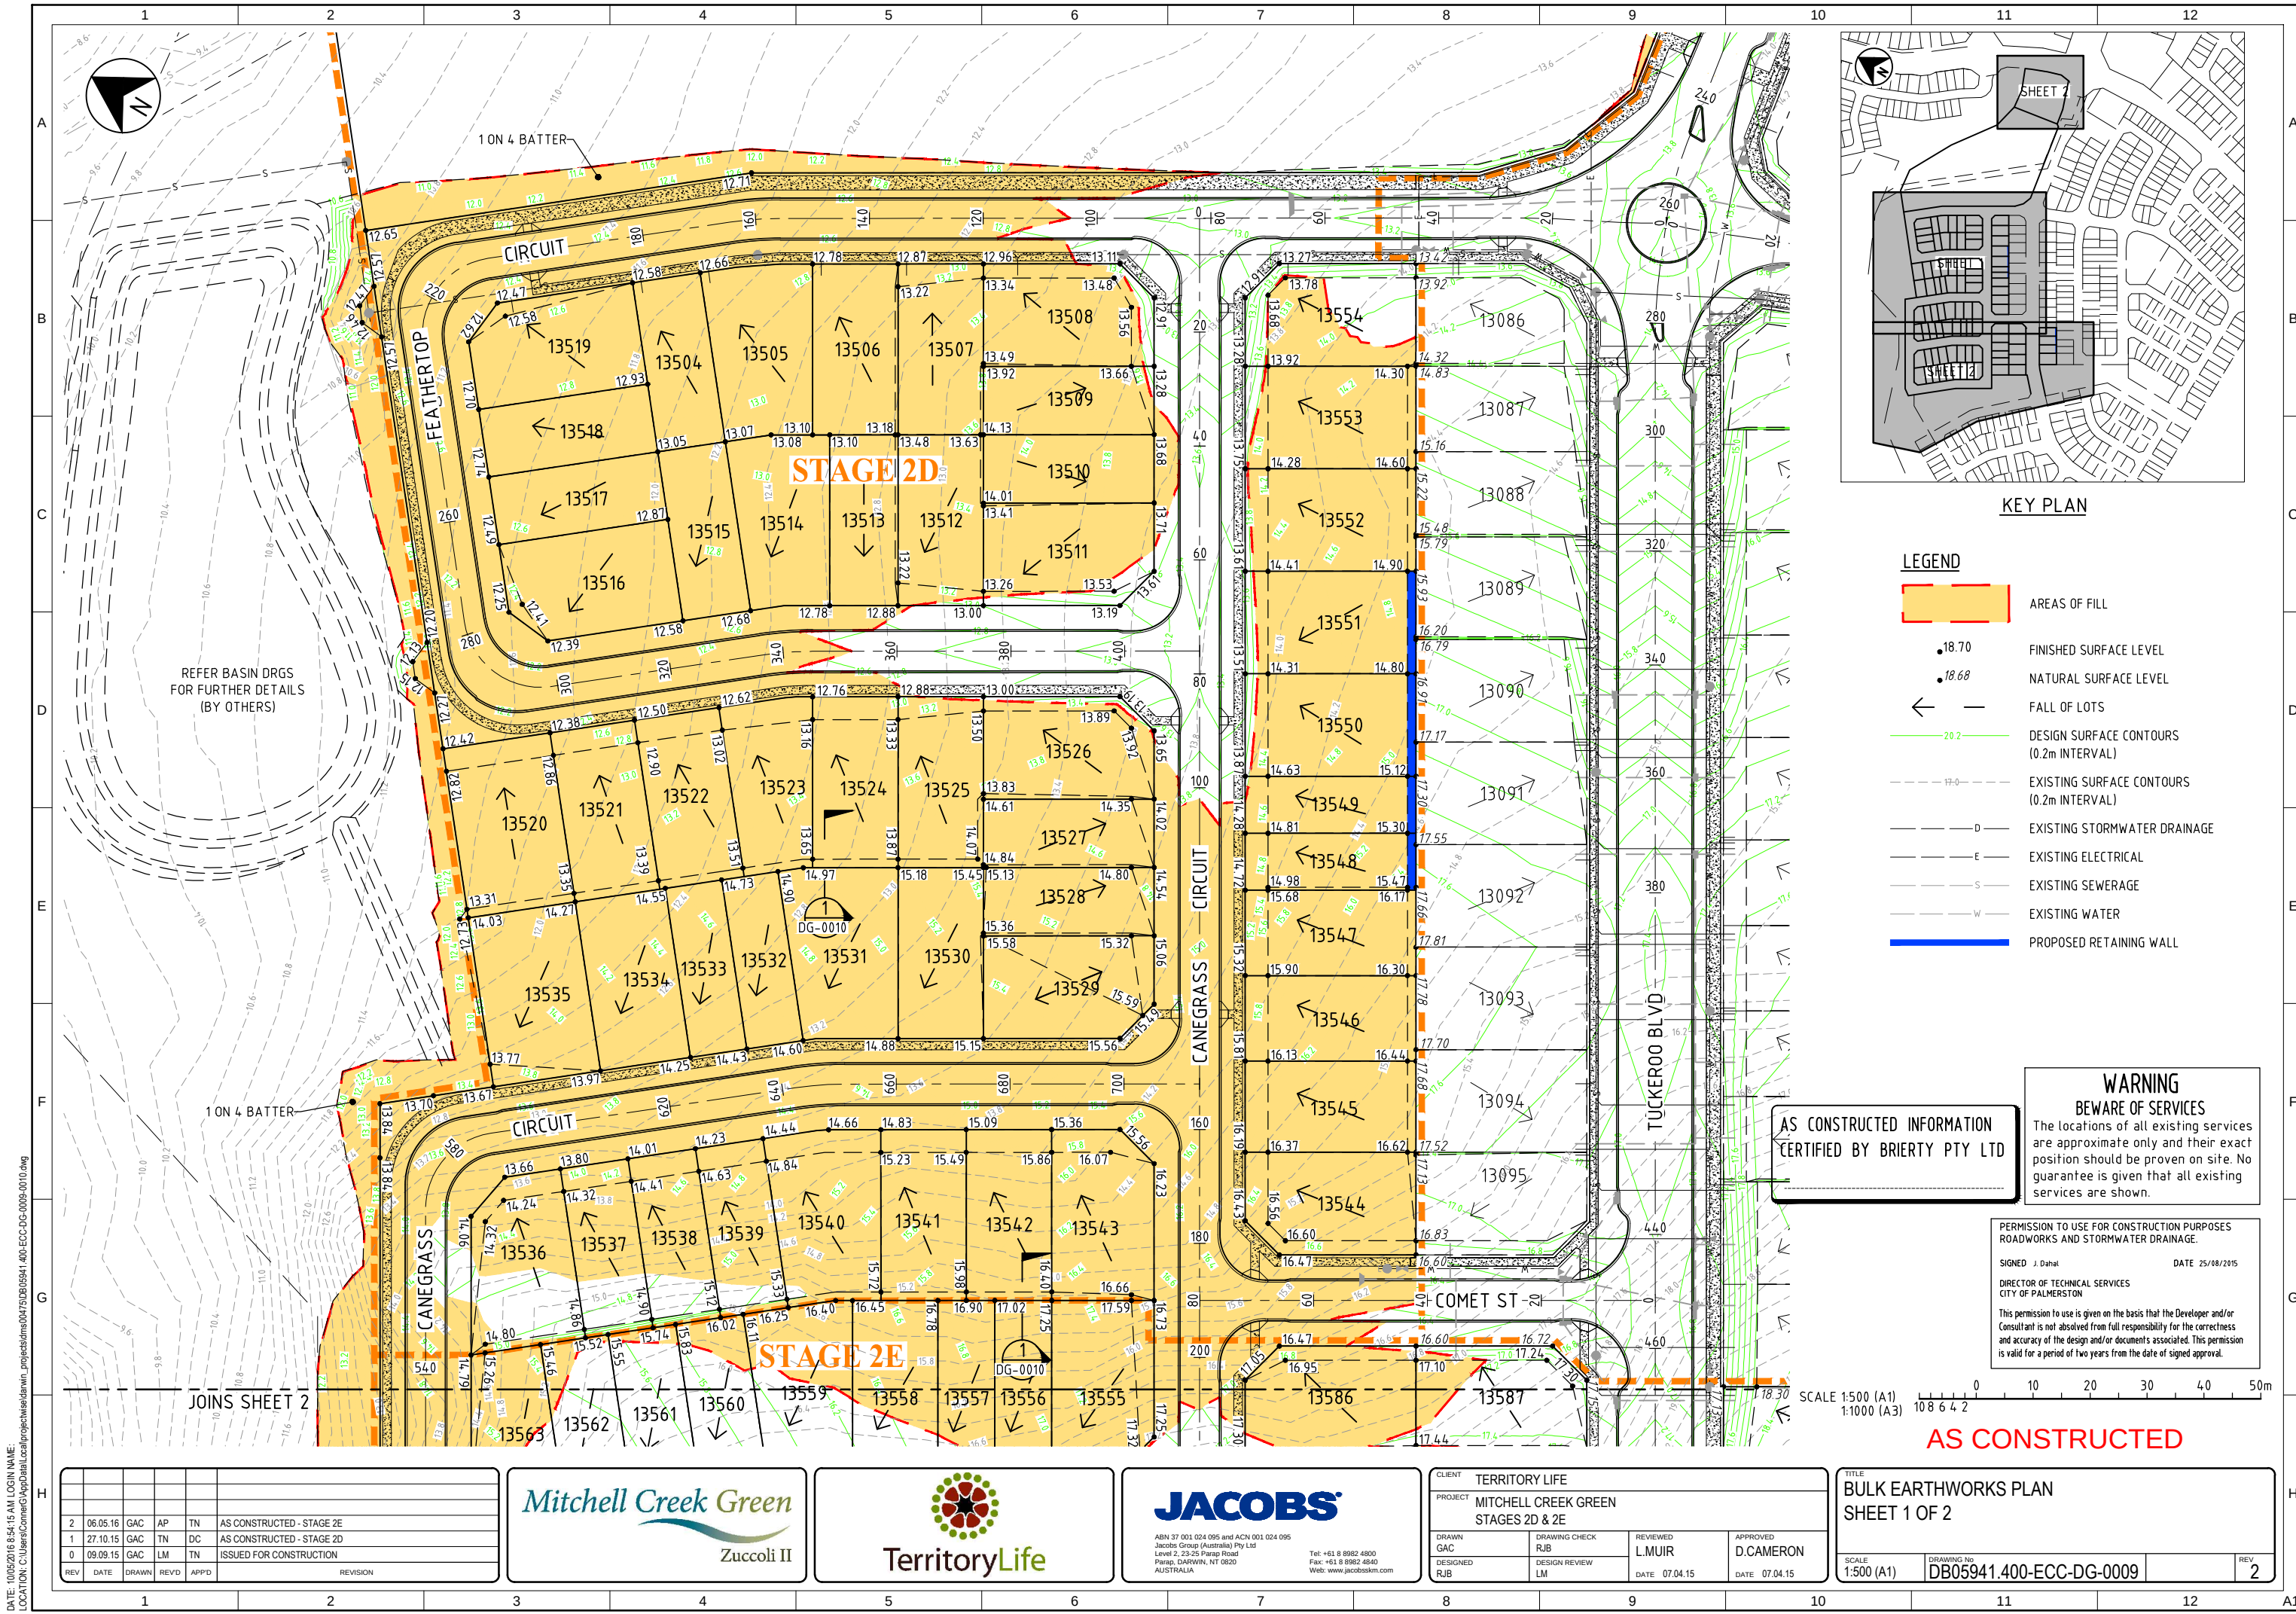


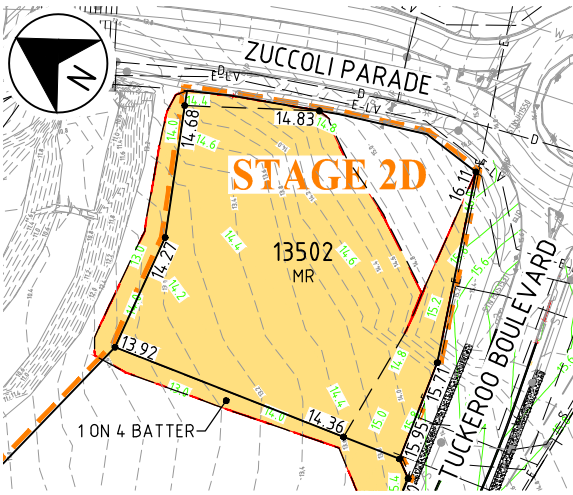

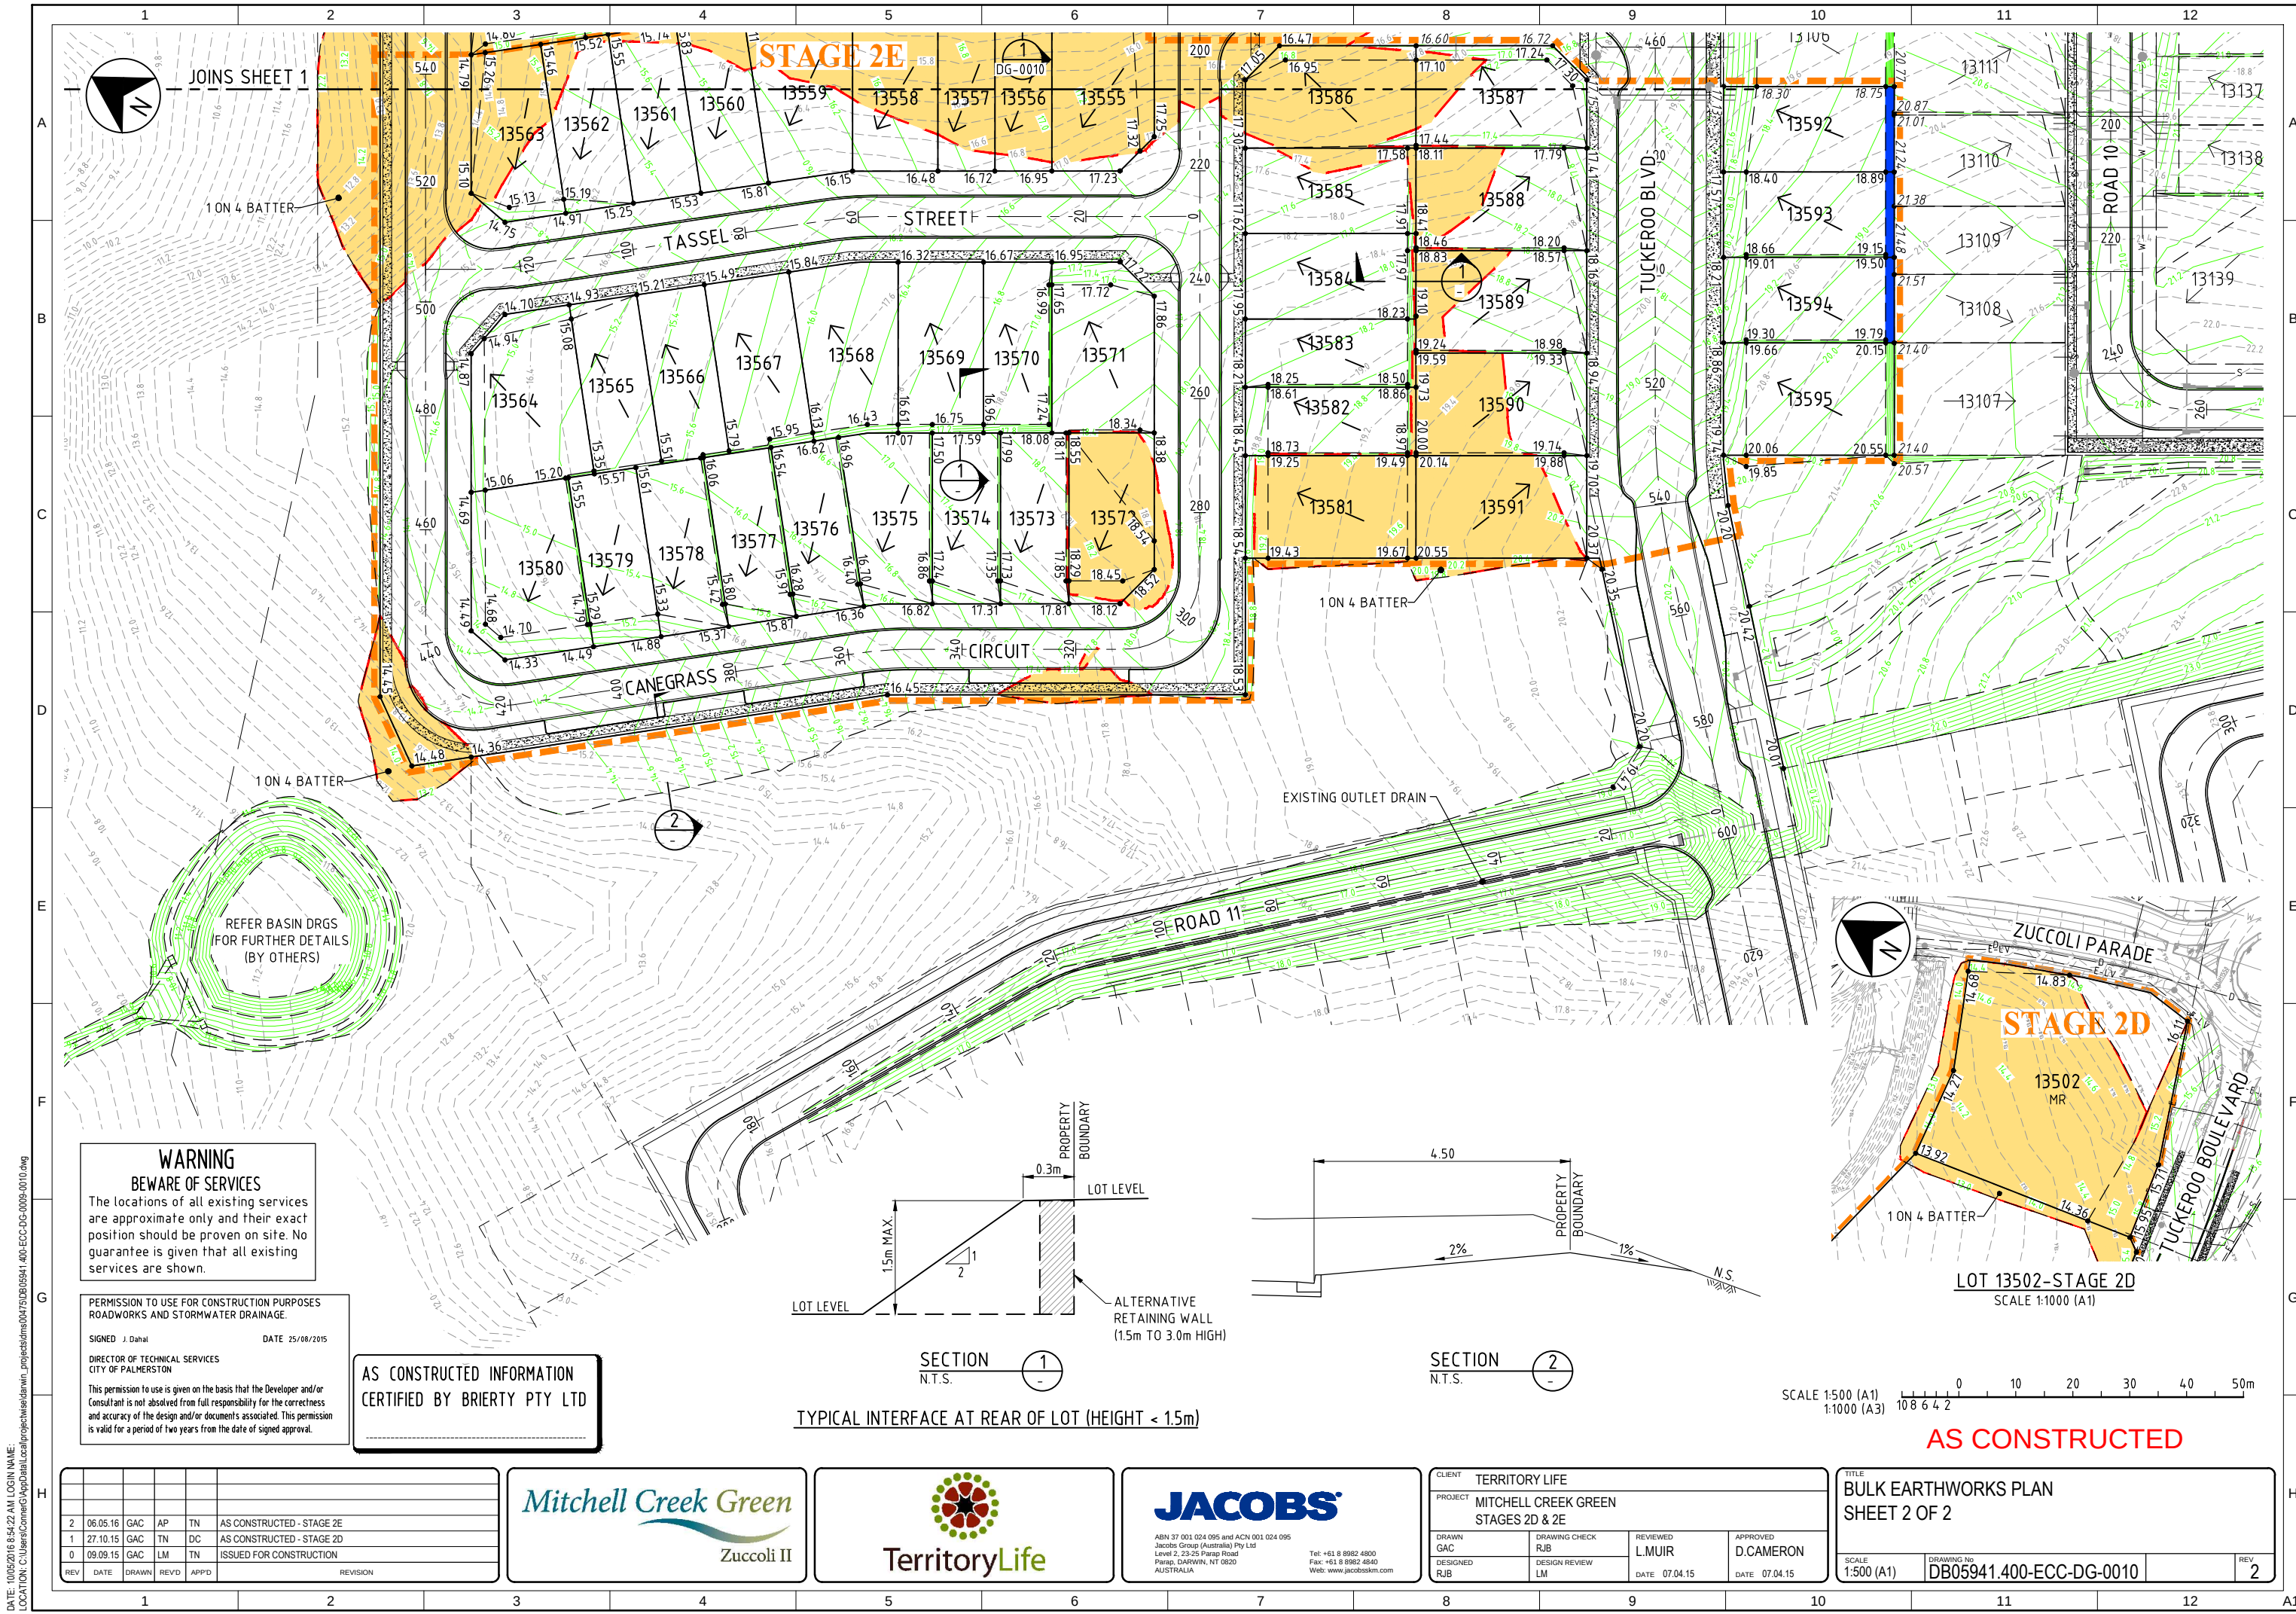

LOT 13502-STAGE 2D
SCALE 1:1000 (A1)


**WARNING
BEWARE OF SERVICES**
The locations of all existing services are approximate only and their exact position should be proven on site. No guarantee is given that all existing services are shown.

PERMISSION TO USE FOR CONSTRUCTION PURPOSES
ROADWORKS AND STORMWATER DRAINAGE.


SIGNED J. Dahal DATE 25/08/2015
DIRECTOR OF TECHNICAL SERVICES
CITY OF PALMERSTON

This permission to use is given on the basis that the Developer and/or Consultant is not absolved from full responsibility for the correctness and accuracy of the design and/or documents associated. This permission is valid for a period of two years from the date of signed approval.

AS CONSTRUCTED INFORMATION
CERTIFIED BY BRIERTY PTY LTD

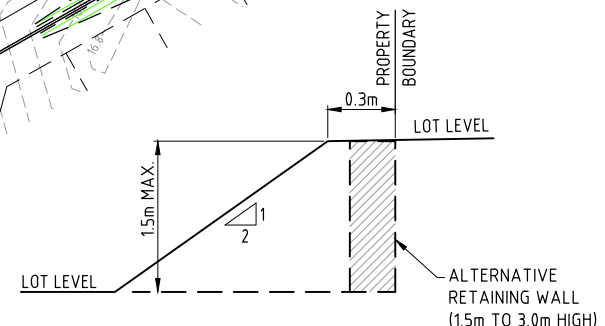

SECTION 1
N.T.S.
TYPICAL INTERFACE AT REAR OF LOT (HEIGHT < 1.5m)

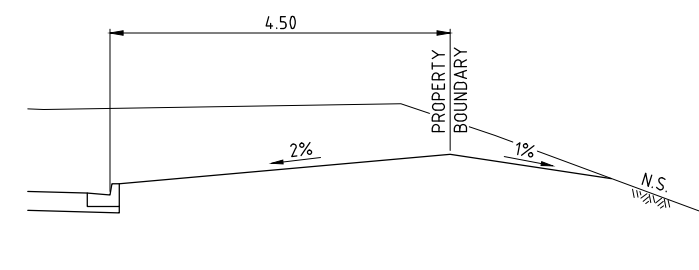


SECTION 2
N.T.S.

SCALE 1:500 (A1)
1:1000 (A3)
0 10 20 30 40 50m
10 8 6 4 2

AS CONSTRUCTED

REV	DATE	DRAWN	REV'D	APP'D	REVISION
2	06.05.16	GAC	AP	TN	AS CONSTRUCTED - STAGE 2E
1	27.10.15	GAC	TN	DC	AS CONSTRUCTED - STAGE 2D
0	09.09.15	GAC	LM	TN	ISSUED FOR CONSTRUCTION

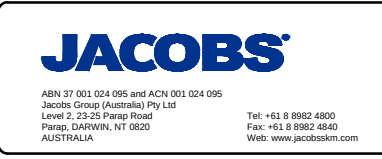

CLIENT	TERRITORY LIFE
PROJECT	MITCHELL CREEK GREEN STAGES 2D & 2E
DRAWN	GAC
DESIGNED	RJB
DRAWING CHECK	RJB
DESIGN REVIEW	LM
REVIEWED	L.MUIR
DATE	07.04.15
APPROVED	D.CAMERON
DATE	07.04.15

TITLE	BULK EARTHWORKS PLAN
	SHEET 2 OF 2
SCALE	1:500 (A1)
DRAWING No	DB05941.400-ECC-DG-0010
REV	2