


LEGEND

MAJOR CONTOURS 1m

MINOR CONTOURS 200mm

LOT BOUNDARY

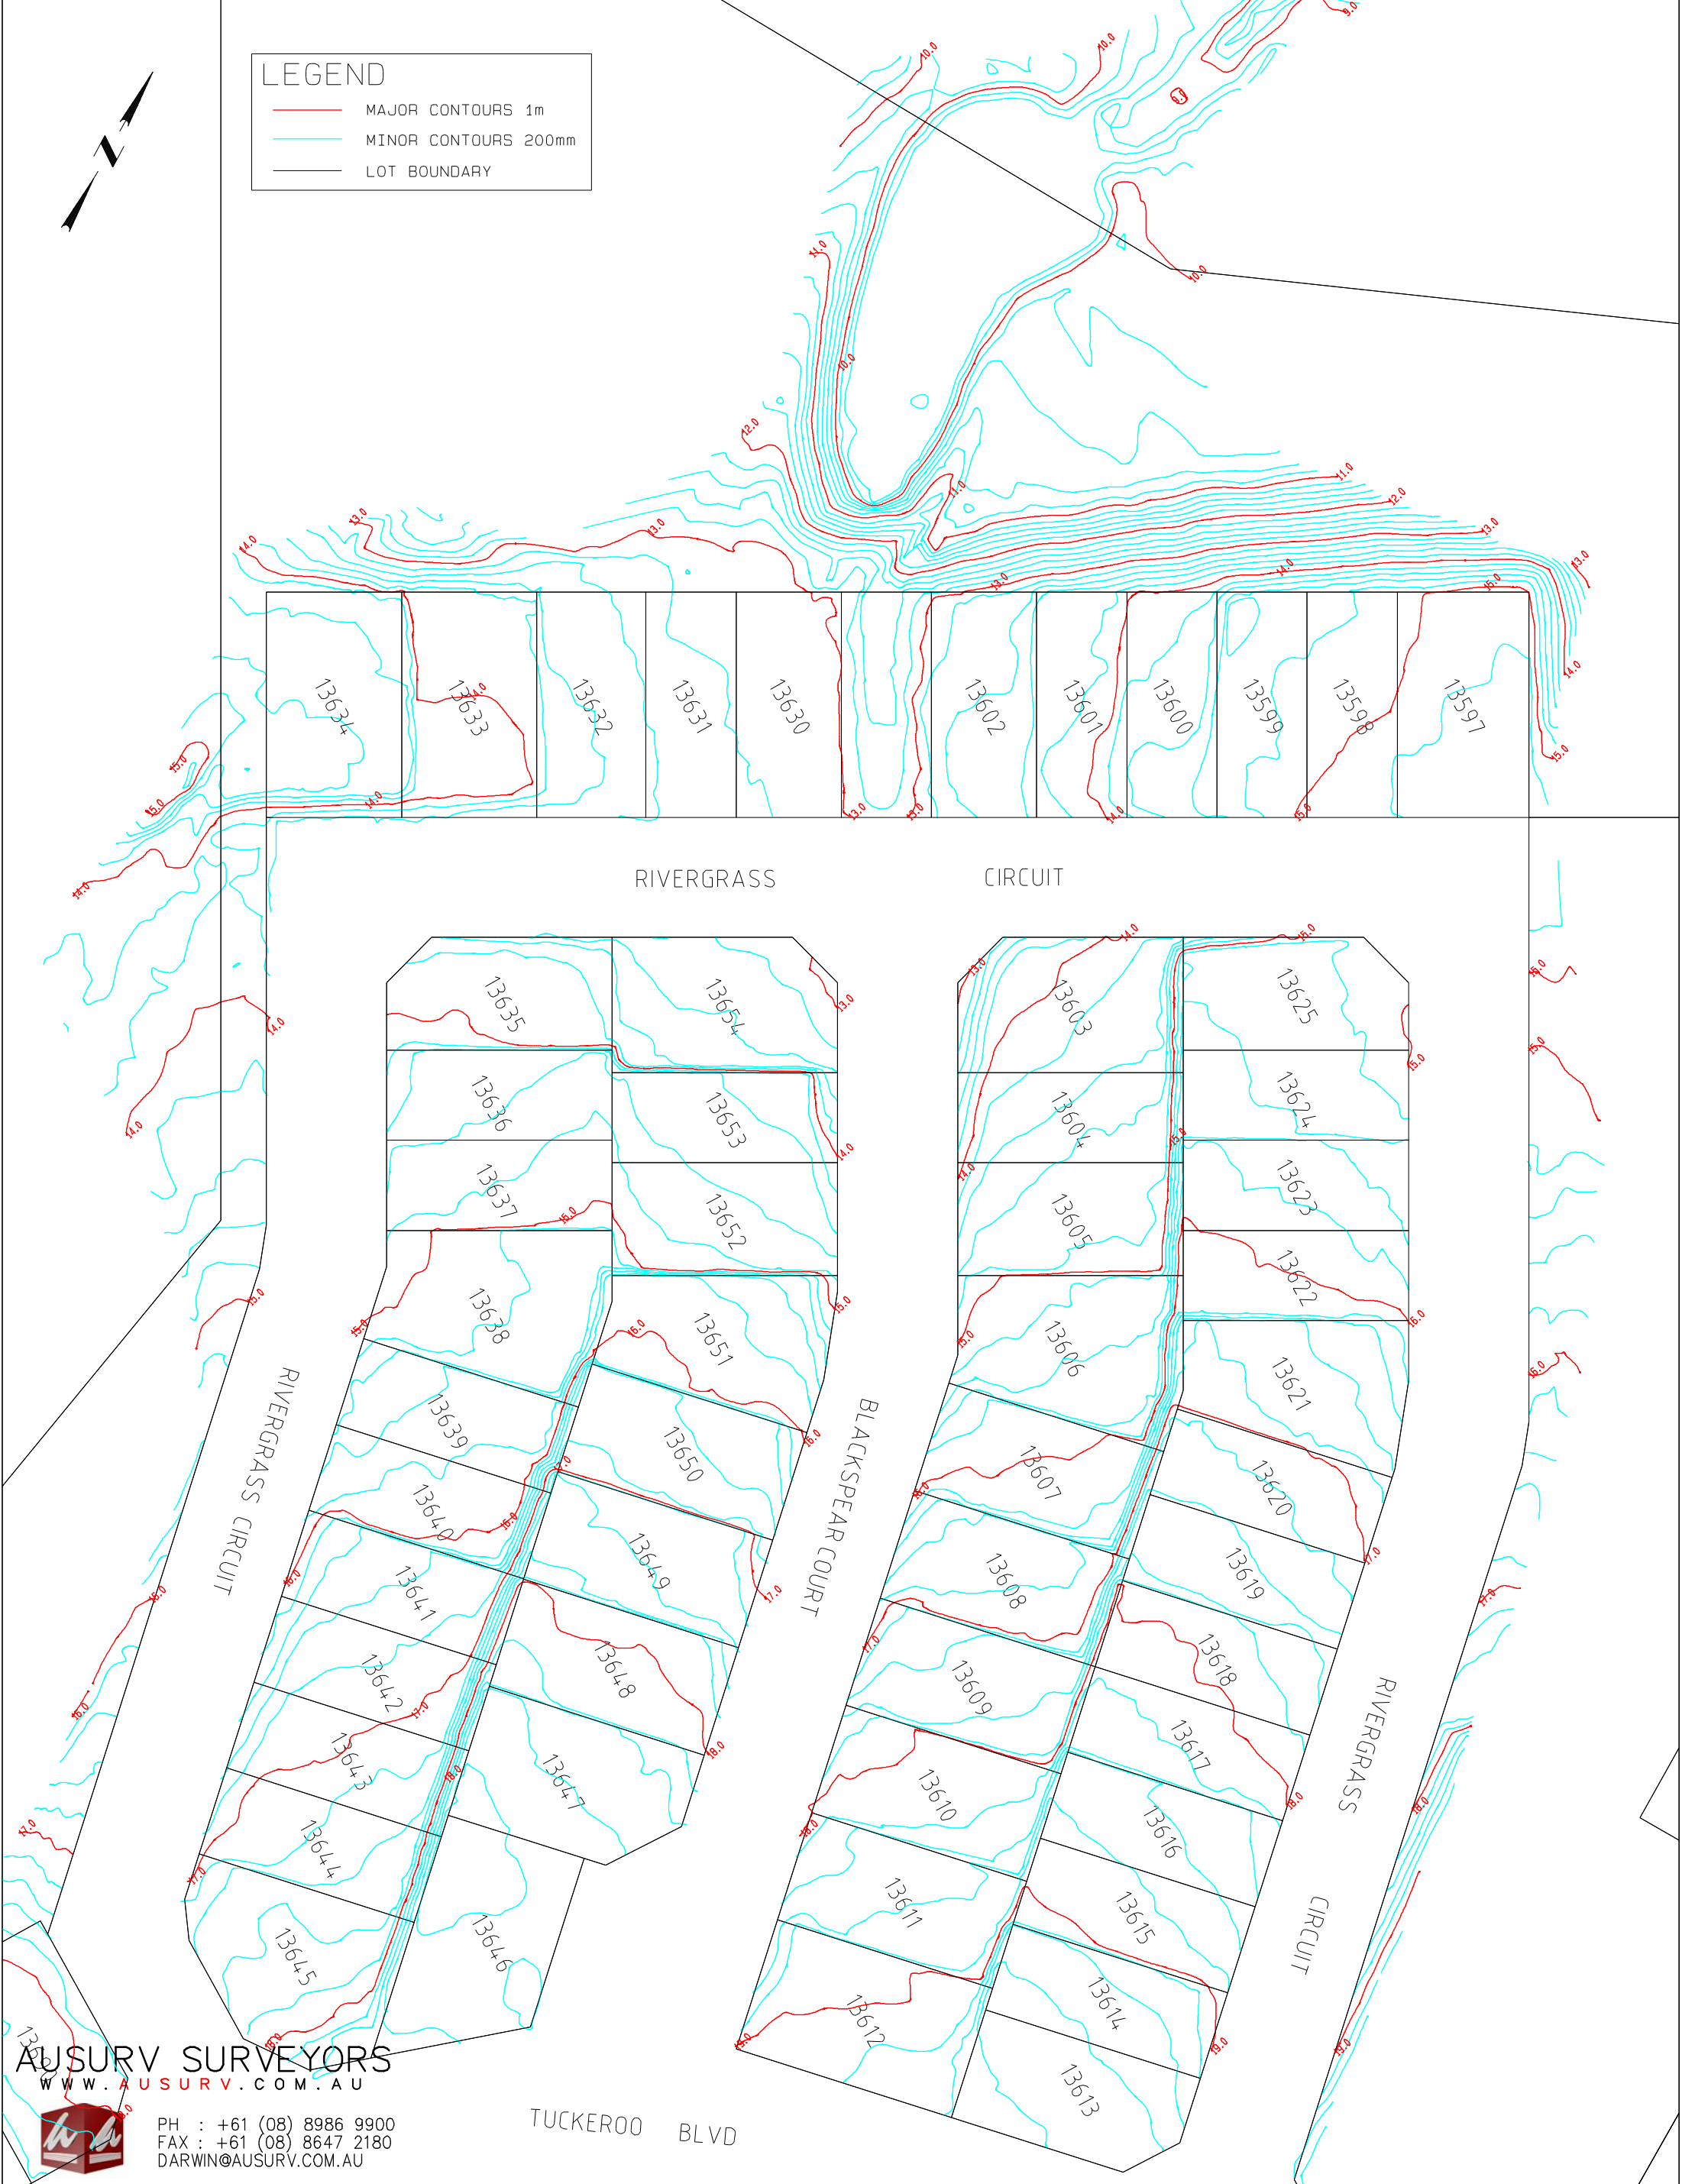


AUSURV SURVEYORS

WWW.AUSURV.COM.AU



PH : +61 (08) 8986 9900
FAX : +61 (08) 8647 2180
DARWIN@AUSURV.COM.AU

INSTRUMENT SERIAL NO.				UAV DRONE				Project Title: ZUCCOLI RESIDENTIAL SUBDIVISION				Drawing Set: ASBUILT DETAIL SURVEY				Plotted 23/11/2016			
CALIBRATION EXP.												Drawing Title: ZUCCOLI 2F ASBUILT SURVEY LOT CONTOURS				Date of Survey 11/11/2016			
												Scale 1:800				Contours 200mm		Drawing Number: 14-0275 - 2F Asbuilt Survey LC_01	
												Sheet Size A3				Sheet 1 of 2			
01	DH	23/11/16	2F Asbuilt Survey Lot Contours 200mm				DH	RW	HG	CB	Datum: Horz: Local Site Vert: Australian Height Datum								
REV	BY	DATE	REVISION RECORD				DRW	SVY	ASST	CHK									

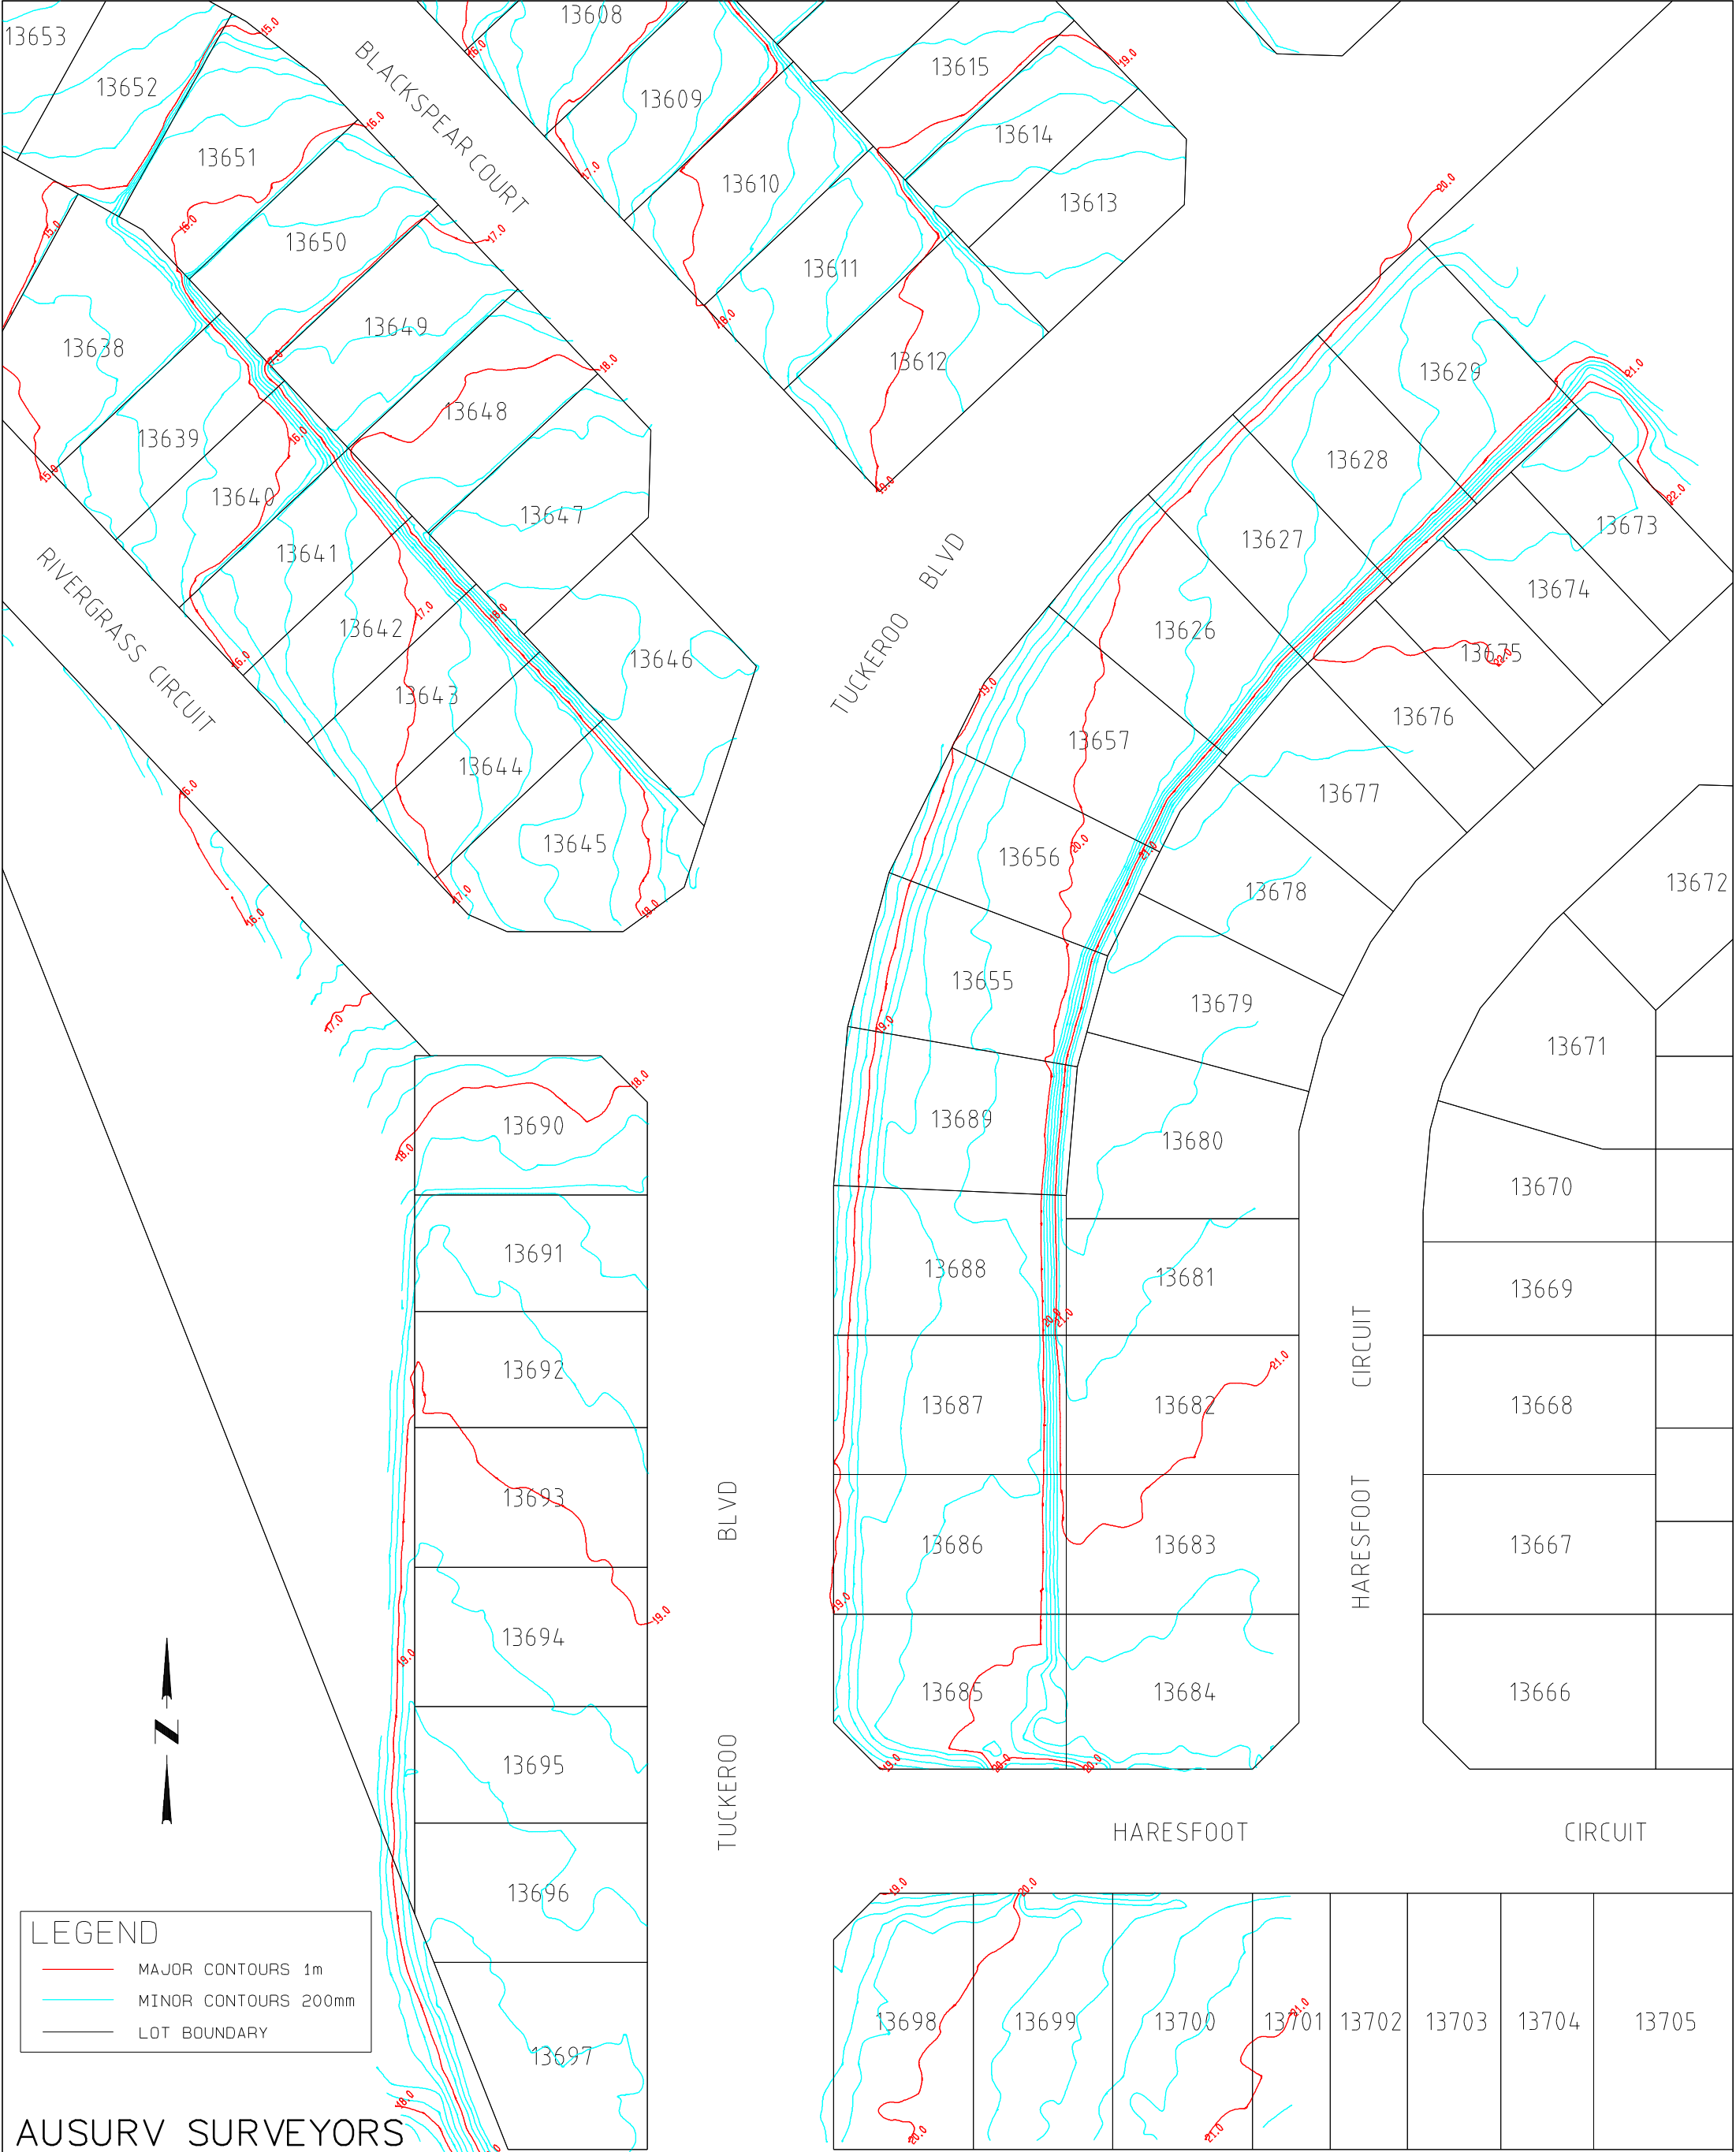

AUSURV SURVEYORS

WWW.AUSURV.COM.AU



PH : +61 (08) 8986 9900
FAX : +61 (08) 8647 2180
DARWIN@AUSURV.COM.AU

INSTRUMENT SERIAL NO.				UAV DRONE				Project Title: ZUCCOLI RESIDENTIAL SUBDIVISION Scale1:800Contours200mm Sheet SizeA3Sheet2 of 2				Drawing Set: SURVEY				Plotted 23/11/2016	
CALIBRATION EXP.												Drawing Title: ZUCCOLI 2F ASBUILT SURVEY LOT CONTOURS				Date of Survey 11/11/2016	
												Datum: Horz: Local Site Vert: Australian Height Datum				Drawing Number: 14-0275 - 2F Asbuilt Survey LC_01	
01	DH	23/11/16	2F Asbuilt Survey Lot Contours 200mm				DH					RW	HG	CB			
REV	BY	DATE	REVISION RECORD				DRW	SVY	ASST	CHK							