


AS CONSTRUCTED INFORMATION
CERTIFIED BY BRIERTY PTY LTD

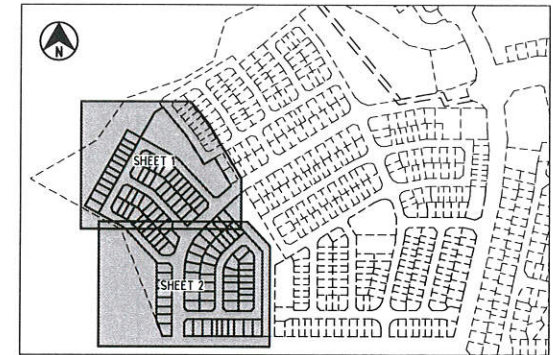

KEY PLAN

LEGEND

- STORMWATER DRAINAGE
- WATER RETICULATION
- SEWERAGE
- ELECTRICAL
- W/S WATER OVER SEWER
- W/D WATER OVER DRAINAGE
- W/E WATER OVER ELECTRICAL
- S/D SEWER OVER DRAINAGE
- D/S DRAINAGE OVER SEWER
- E/D ELECTRICAL OVER DRAINAGE
- E/S ELECTRICAL OVER SEWER
- D/W DRAINAGE OVER WATER
- D/E DRAINAGE OVER ELECTRICAL
- DOUBLE IRRIGATION CONDUIT
- IRRIGATION CONDUIT

NOTES

- REFER DRAINAGE AND SEWER LONGITUDINAL SECTIONS FOR FURTHER DETAILS OF SERVICE CROSSINGS.
- FOR COMMUNICATIONS INFRASTRUCTURE REFER NBN DRAWINGS.

WARNING
BEWARE OF SERVICES

The locations of all existing services are approximate only and their exact position should be proven on site. No guarantee is given that all existing services are shown.

PERMISSION TO USE FOR CONSTRUCTION PURPOSES ONLY
SIGNED: D. Buettighe DATE: 19.04.16
ON BEHALF OF WATER SERVICES FOR THE INCORPORATION INTO POWER AND WATER CORPORATION'S NETWORK.
This permission to use this Approved Design is given on the basis that the developer and/or Consultant is not absolved from full responsibility for the correctness and accuracy of the design and/or documents so associated.
This drawing is valid for 2 years from the date of signing.

SCALE 1:500 (A1) 1:1000 (A3)

CONSTRUCTION ISSUE

REV	DATE	DRAWN	REV'D	APPR'D	REVISION
1	11.11.16	JP	AP	RK	AS CONSTRUCTED - STAGE 2F
0	16.05.16	GAC	TN	JM	ISSUED FOR CONSTRUCTION


Mitchell Creek Green
Zuccoli II

TerritoryLife

JACOBS
ABN 37 001 024 006 and ACN 001 024 006
JACOBS GROUP AUSTRALIA PTY LTD
Level 2, 23-25 Park Road
Parramatta, NSW 2150
AUSTRALIA
Tel: +61 8 5802 4600
Fax: +61 8 5802 4600
Web: www.jacobs.com.au

CLIENT	TERRITORY LIFE
PROJECT	MITCHELL CREEK GREEN STAGES 2F & 2G
DRAWN	DRAWING CHECK
GAC	TAB
DESIGNED	DESIGN REVIEW
RJB	TN
DATE	14.12.15
DATE	14.12.15

TITLE	MASTER SERVICES PLAN SHEET 1 OF 2
SCALE	1:500 (A1)
DRAWING NO.	DB05941.600-ECC-DG-0051
PROJECT NO.	B15-7336
REV	1

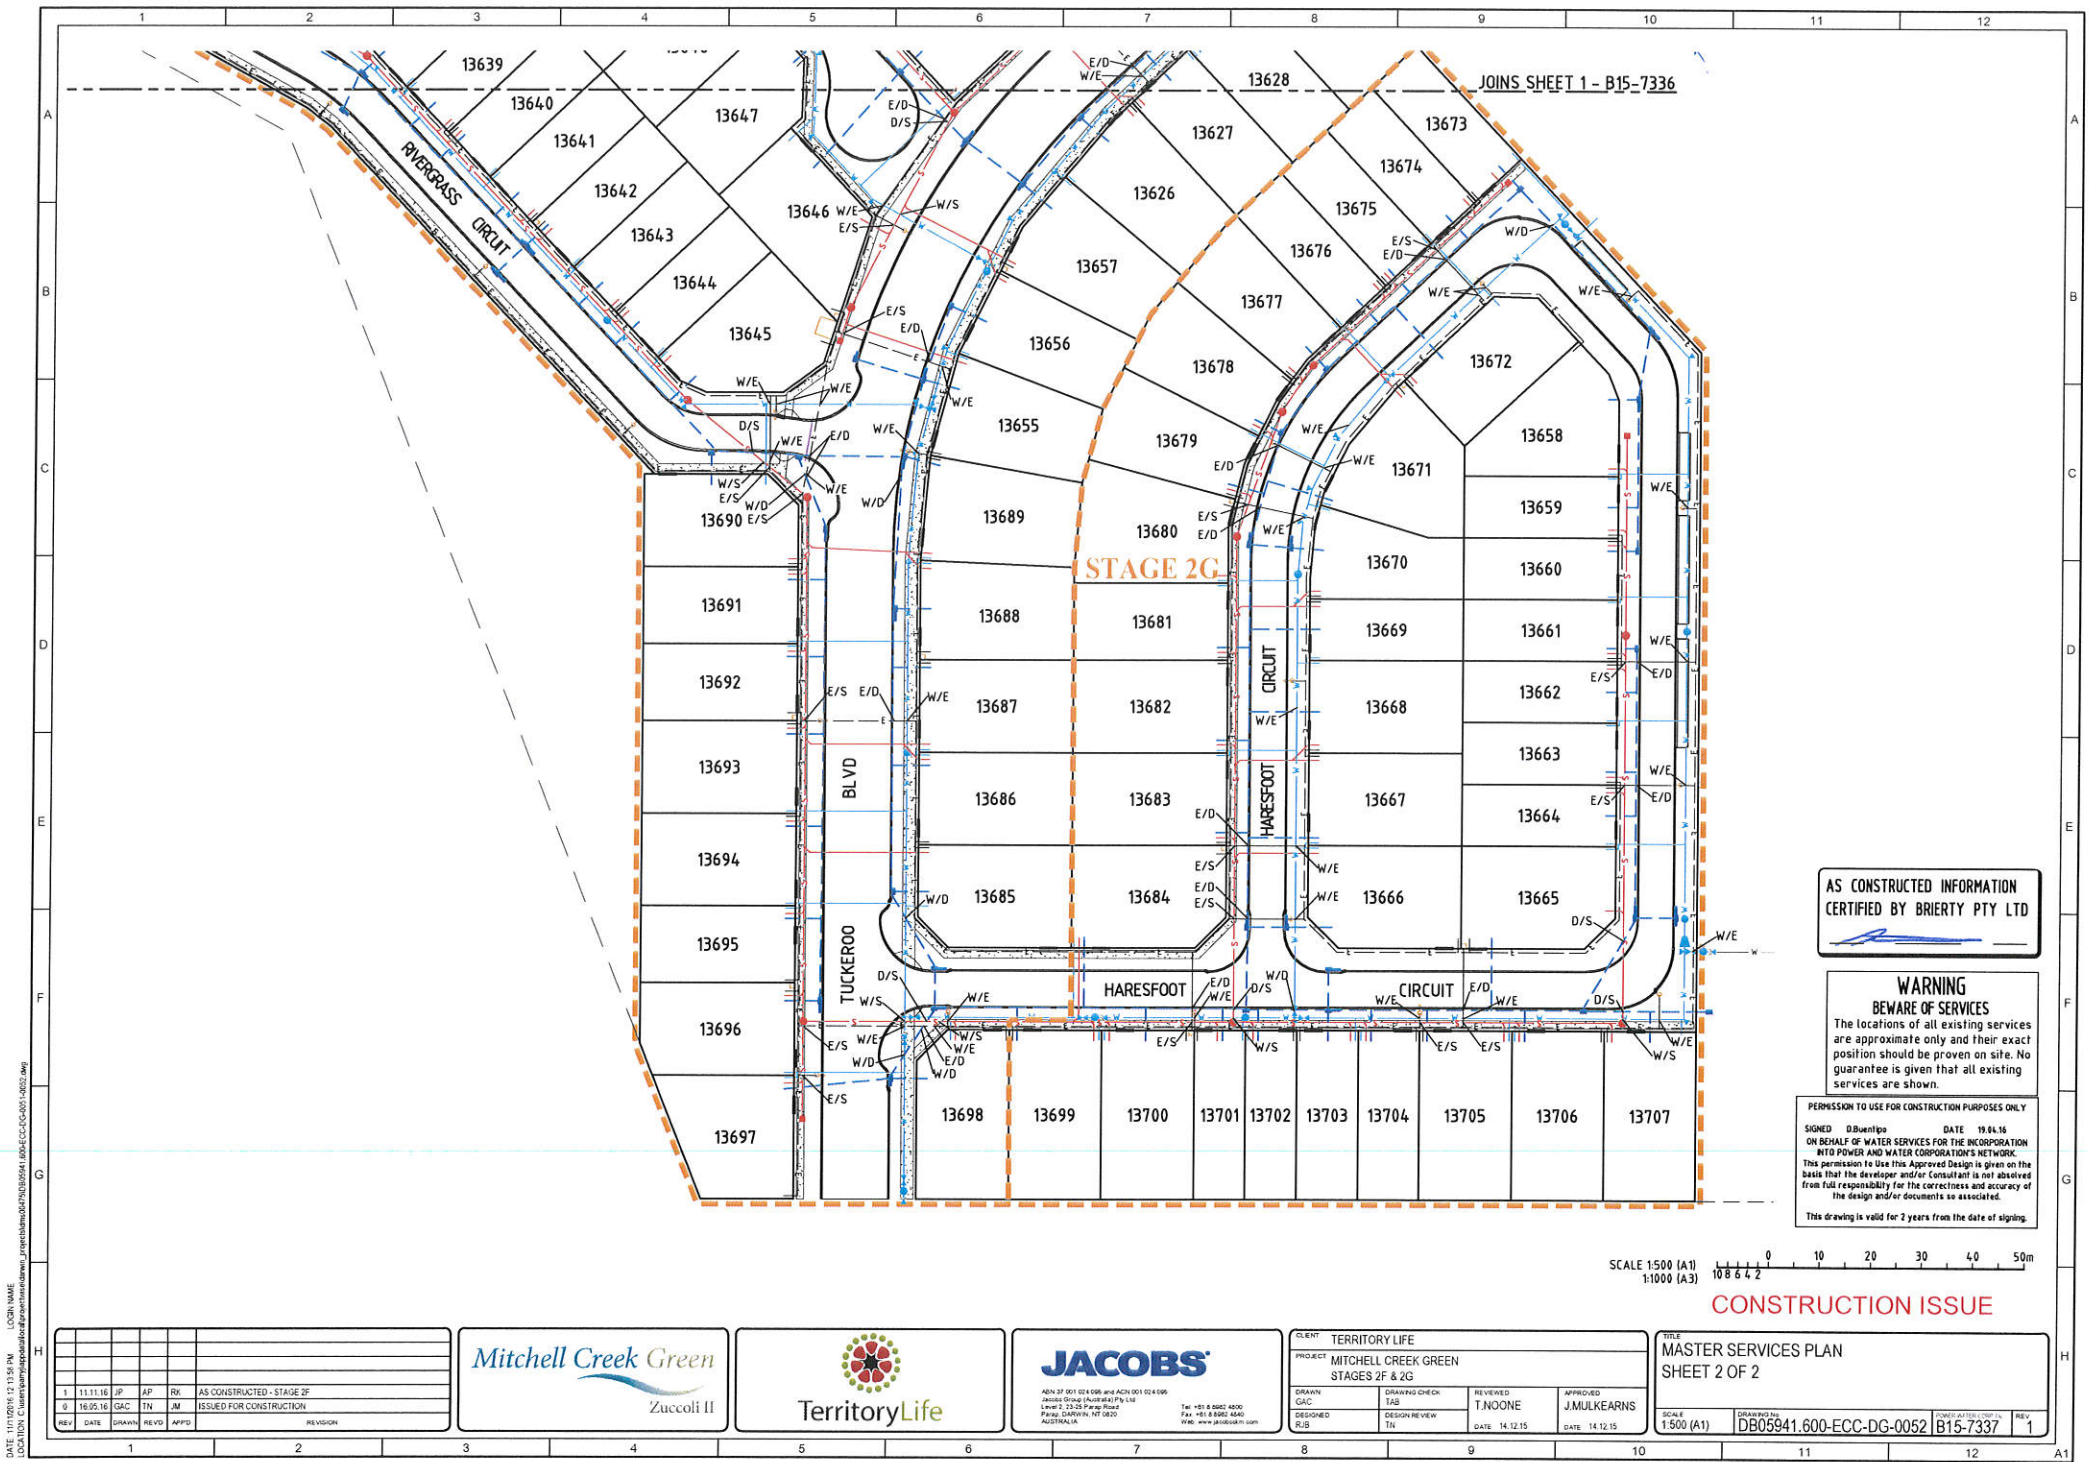

JOINS SHEET 1 - B15-7336

STAGE 2G

AS CONSTRUCTED INFORMATION
CERTIFIED BY BRIERTY PTY LTD

**WARNING
BEWARE OF SERVICES**
The locations of all existing services are approximate only and their exact position should be proven on site. No guarantee is given that all existing services are shown.

PERMISSION TO USE FOR CONSTRUCTION PURPOSES ONLY
SIGNED: D. Buentpo DATE: 19.04.16
ON BEHALF OF WATER SERVICES FOR THE INCORPORATION
INTO POWER AND WATER CORPORATION'S NETWORK.
This permission to use this Approved Design is given on the basis that the developer and/or Consultant is not absolved from full responsibility for the correctness and accuracy of the design and/or documents so associated.
This drawing is valid for 2 years from the date of signing.

SCALE 1:500 (A1)
1:1000 (A3)


CONSTRUCTION ISSUE

REV	DATE	DRAWN	REV'D	APP'D	REVISION
1	11.11.16	JP	AP	RK	AS CONSTRUCTED - STAGE 2F
0	16.05.16	GAC	TN	JM	ISSUED FOR CONSTRUCTION



CLIENT	TERRITORY LIFE
PROJECT	MITCHELL CREEK GREEN STAGES 2F & 2G
DRAWN	GAC
DESIGNED	RJB
CHECKED	TAB
REVIEWED	T.NOONE
DATE	14.12.15
APPROVED	J.MULKEARNS
DATE	14.12.15

FILE	MASTER SERVICES PLAN SHEET 2 OF 2
SCALE	1:500 (A1)
DRAWING NO.	DB05941.600-ECC-DG-0052
PROJECT NO.	B15-7337
REV	1

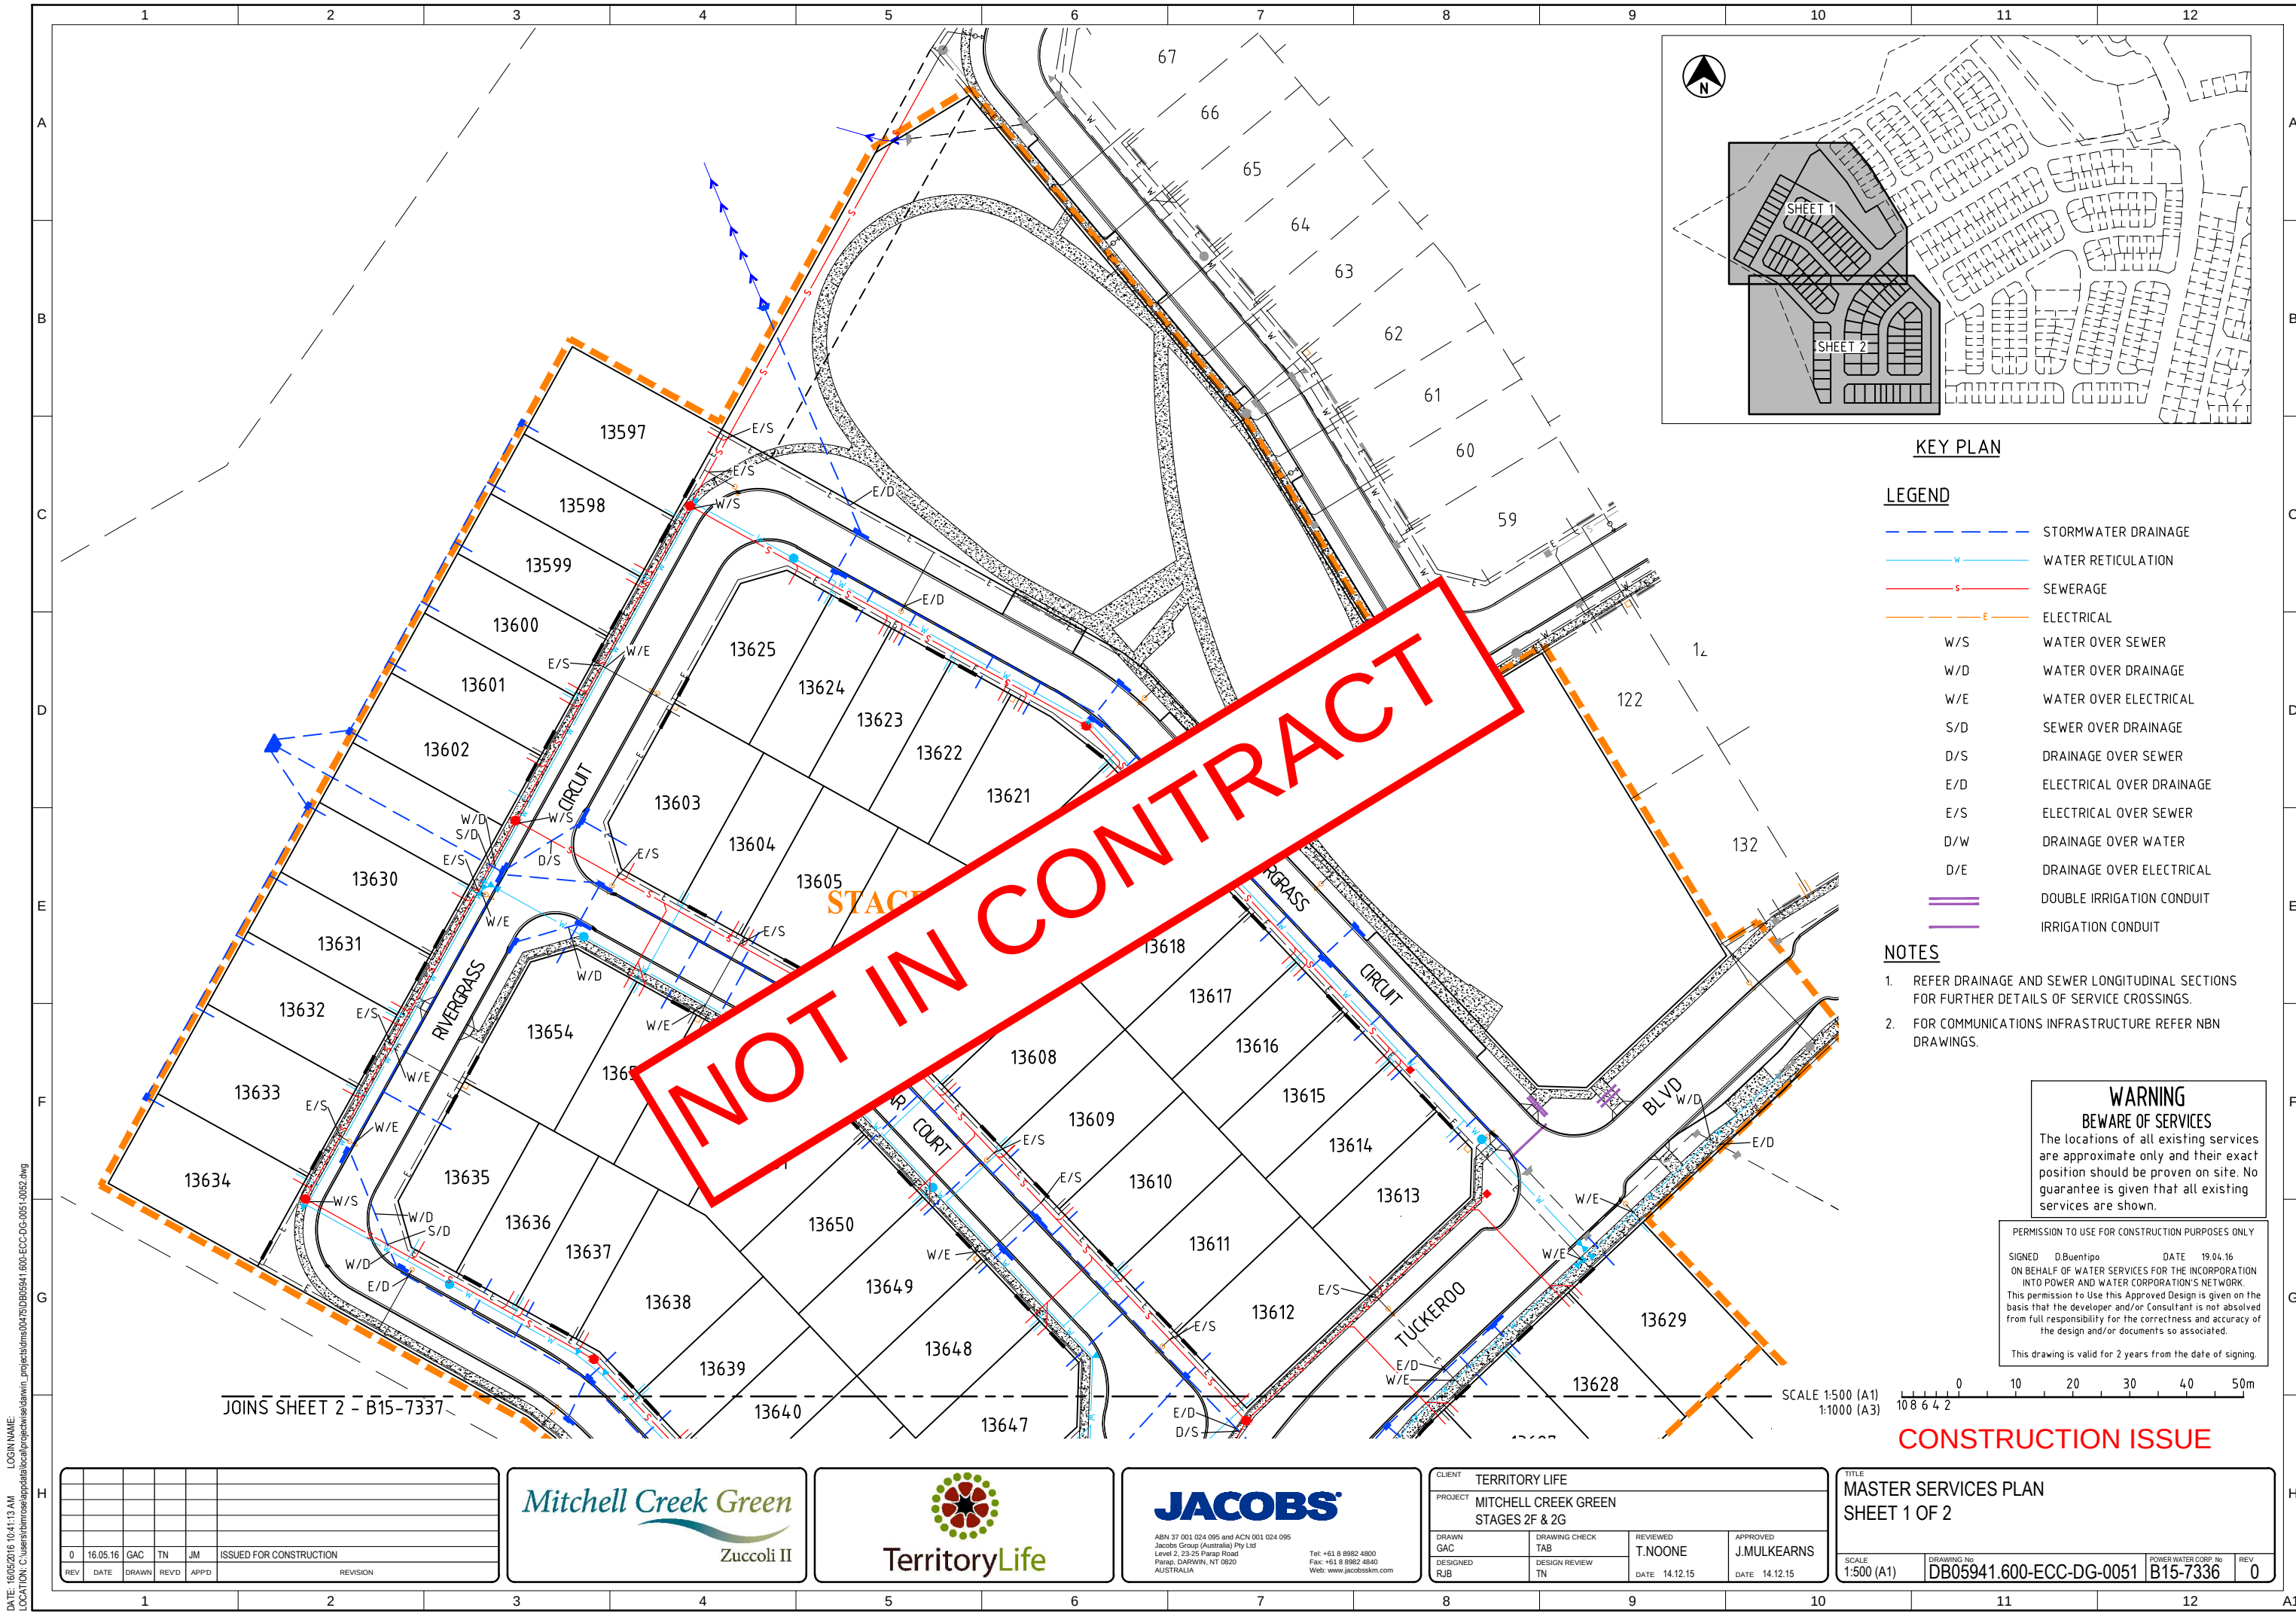


DATE: 16/05/2016 10:41:13 AM LOGIN NAME: LOCATION: C:\Users\mrose\appdata\local\project\mitchellcreekgreen\mitchellcreekgreen.dwg

REV	DATE	DRAWN	REV'D	APP'D	REVISION
0	16.05.16	GAC	TN	JM	ISSUED FOR CONSTRUCTION



CLIENT	TERRITORY LIFE
PROJECT	MITCHELL CREEK GREEN STAGES 2F & 2G
DRAWN	GAC
DESIGNED	RJB
DRAWING CHECK	TAB
DESIGN REVIEW	TN
REVIEWED	T.NOONE
DATE	14.12.15
APPROVED	J.MULKEARNS
DATE	14.12.15

TITLE	MASTER SERVICES PLAN SHEET 1 OF 2
SCALE	1:500 (A1)
DRAWING No	DB05941.600-ECC-DG-0051
POWER WATER CORP No	B15-7336
REV	0

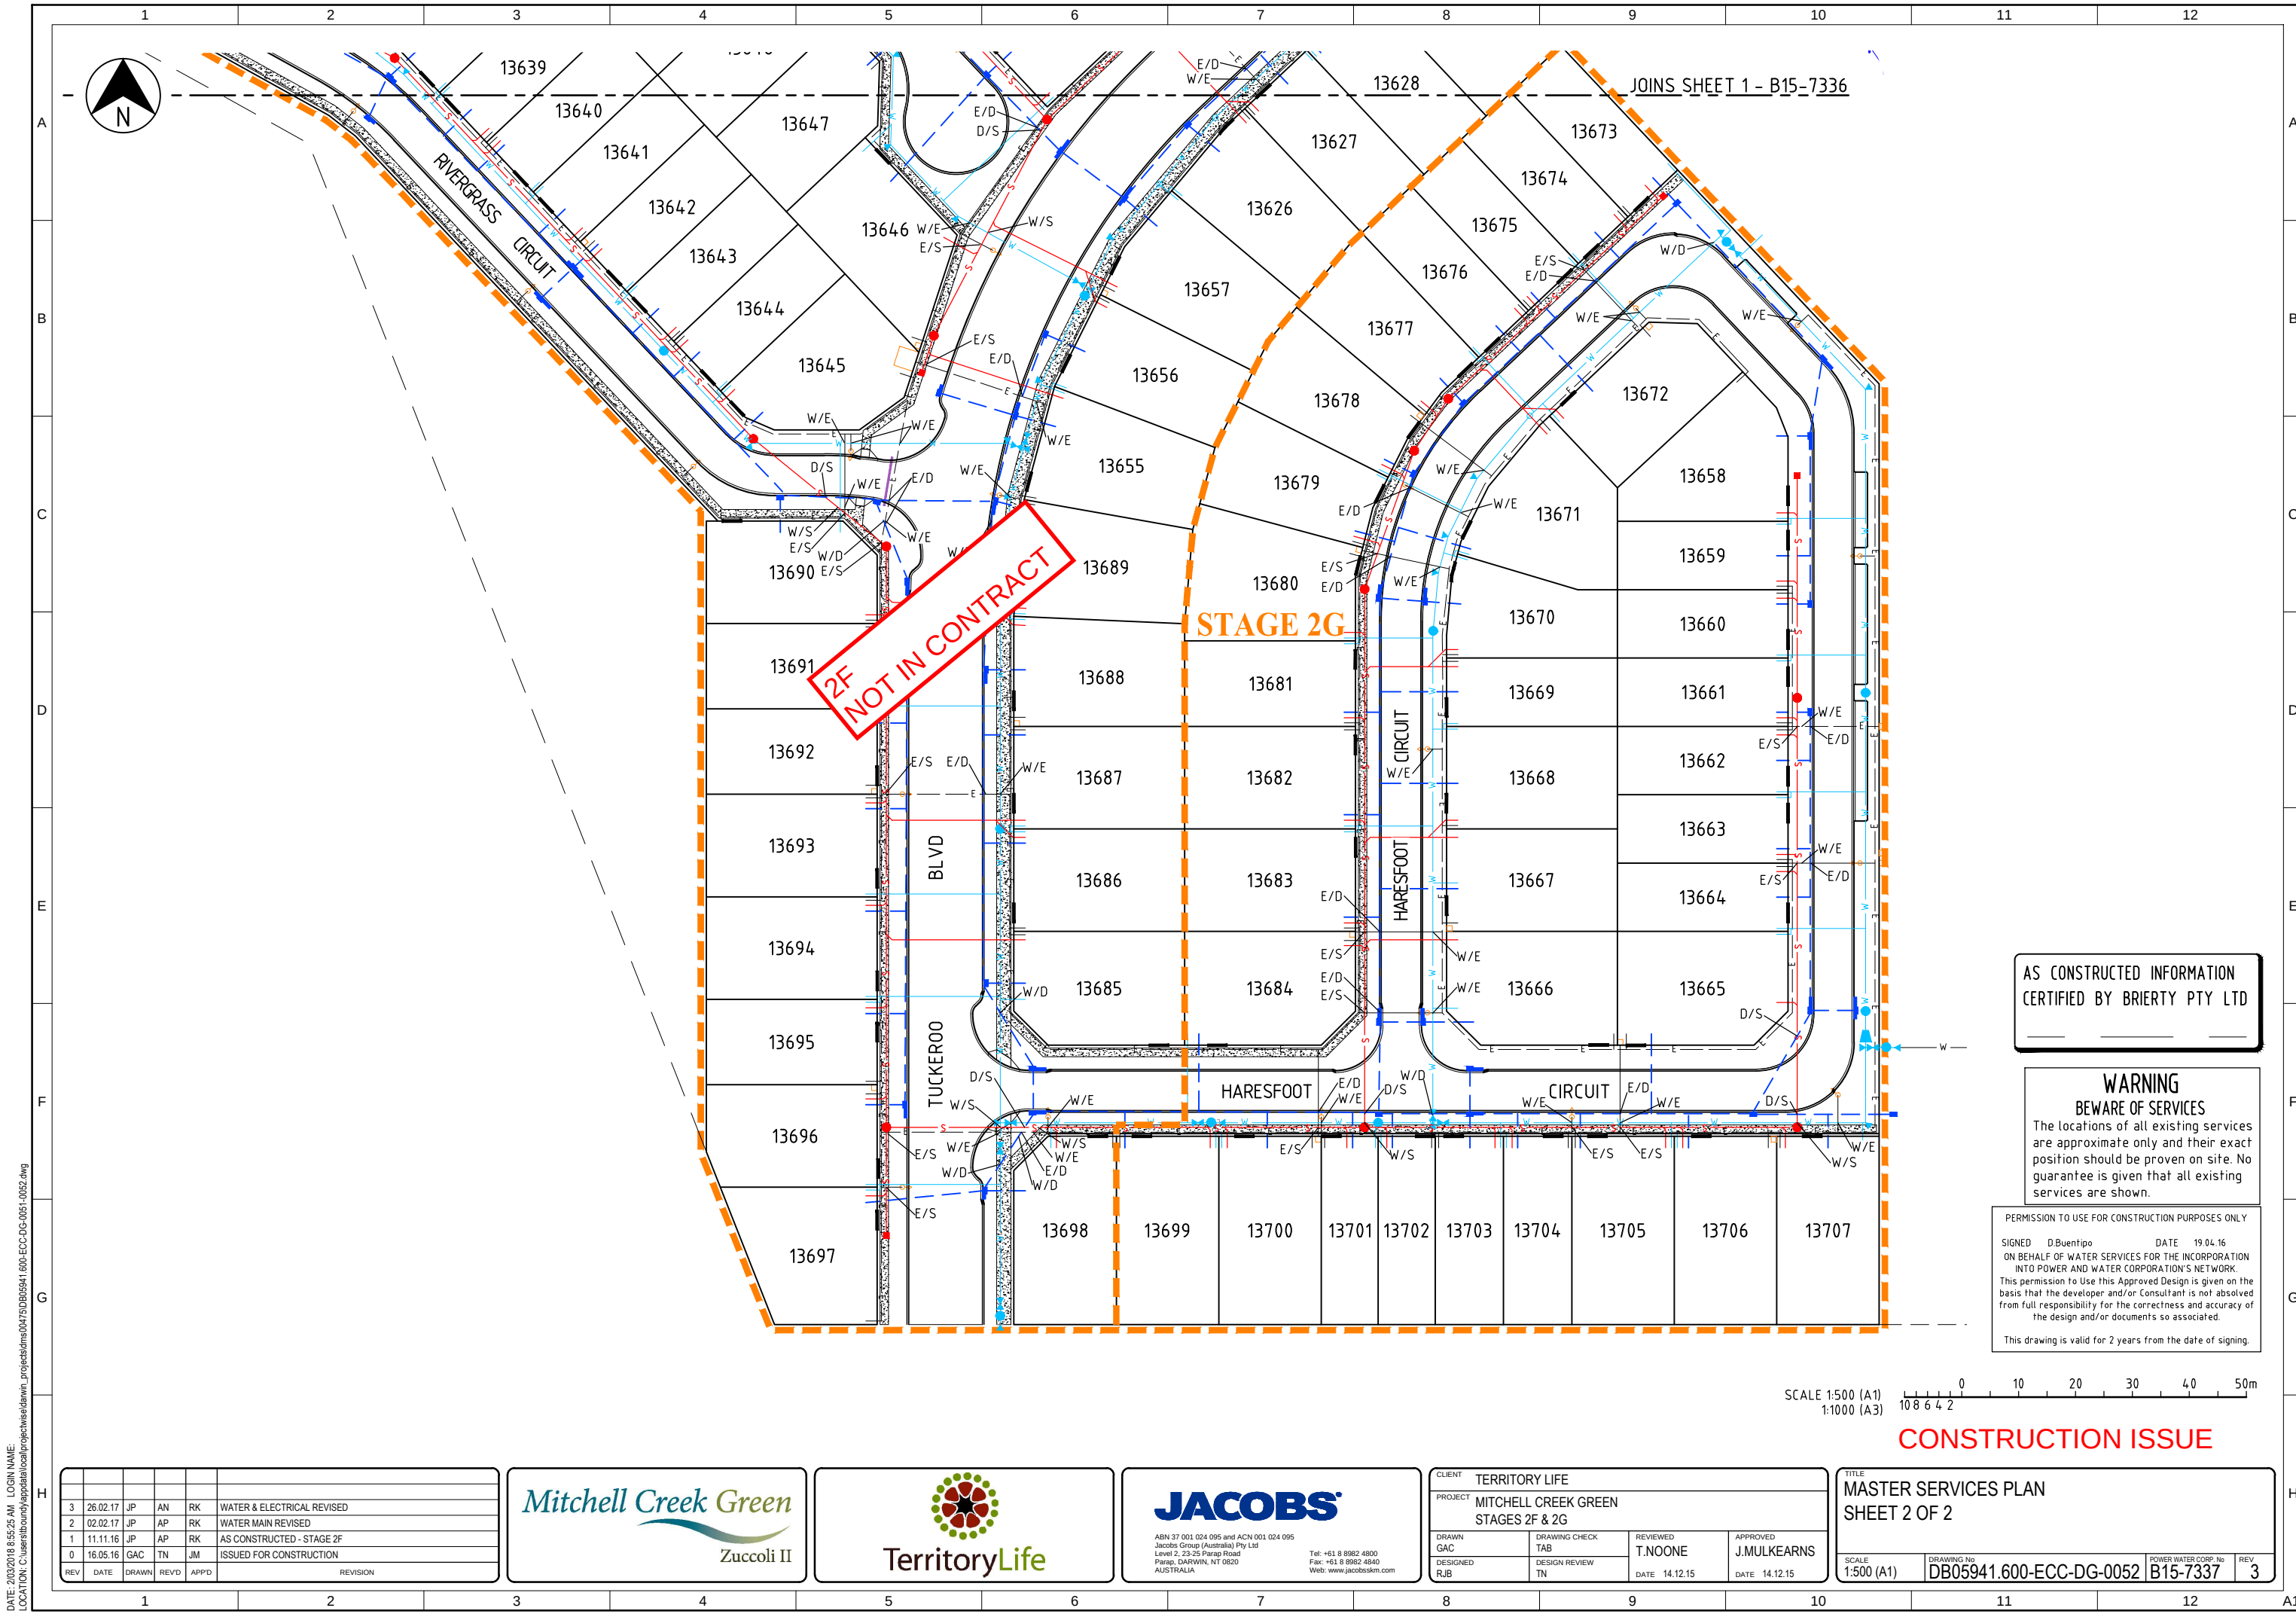

DATE: 2023/01/18 8:55:25 AM LOGIN NAME: C:\Users\stboun\appdata\local\project\mitchell_creek_green\stages_2f_2g\dwg LOCATION: C:\Users\stboun\appdata\local\project\mitchell_creek_green\stages_2f_2g\dwg

REV	DATE	DRAWN	REV'D	APP'D	REVISION
3	26.02.17	JP	AN	RK	WATER & ELECTRICAL REVISED
2	02.02.17	JP	AP	RK	WATER MAIN REVISED
1	11.11.16	JP	AP	RK	AS CONSTRUCTED - STAGE 2F
0	16.05.16	GAC	TN	JM	ISSUED FOR CONSTRUCTION

Mitchell Creek Green

Zuccoli II

TerritoryLife

JACOBS

ABN 37 001 024 095 and ACN 001 024 095
Jacobs Group (Australia) Pty Ltd
Level 2, 23-25 Parap Road
Parap, DARWIN, NT 0820
AUSTRALIA

Tel: +61 8 8982 4800
Fax: +61 8 8982 4840
Web: www.jacobs.com.au

CLIENT	TERRITORY LIFE
PROJECT	MITCHELL CREEK GREEN STAGES 2F & 2G
DRAWN	GAC
DESIGNED	RJB
DRAWING CHECK	TAB
DESIGN REVIEW	TN
REVIEWED	T.NOONE
DATE	14.12.15
APPROVED	J.MULKEARNS
DATE	14.12.15

TITLE	MASTER SERVICES PLAN SHEET 2 OF 2
SCALE	1:500 (A1)
DRAWING No	DB05941.600-ECC-DG-0052
POWER WATER CORP No	B15-7337
REV	3