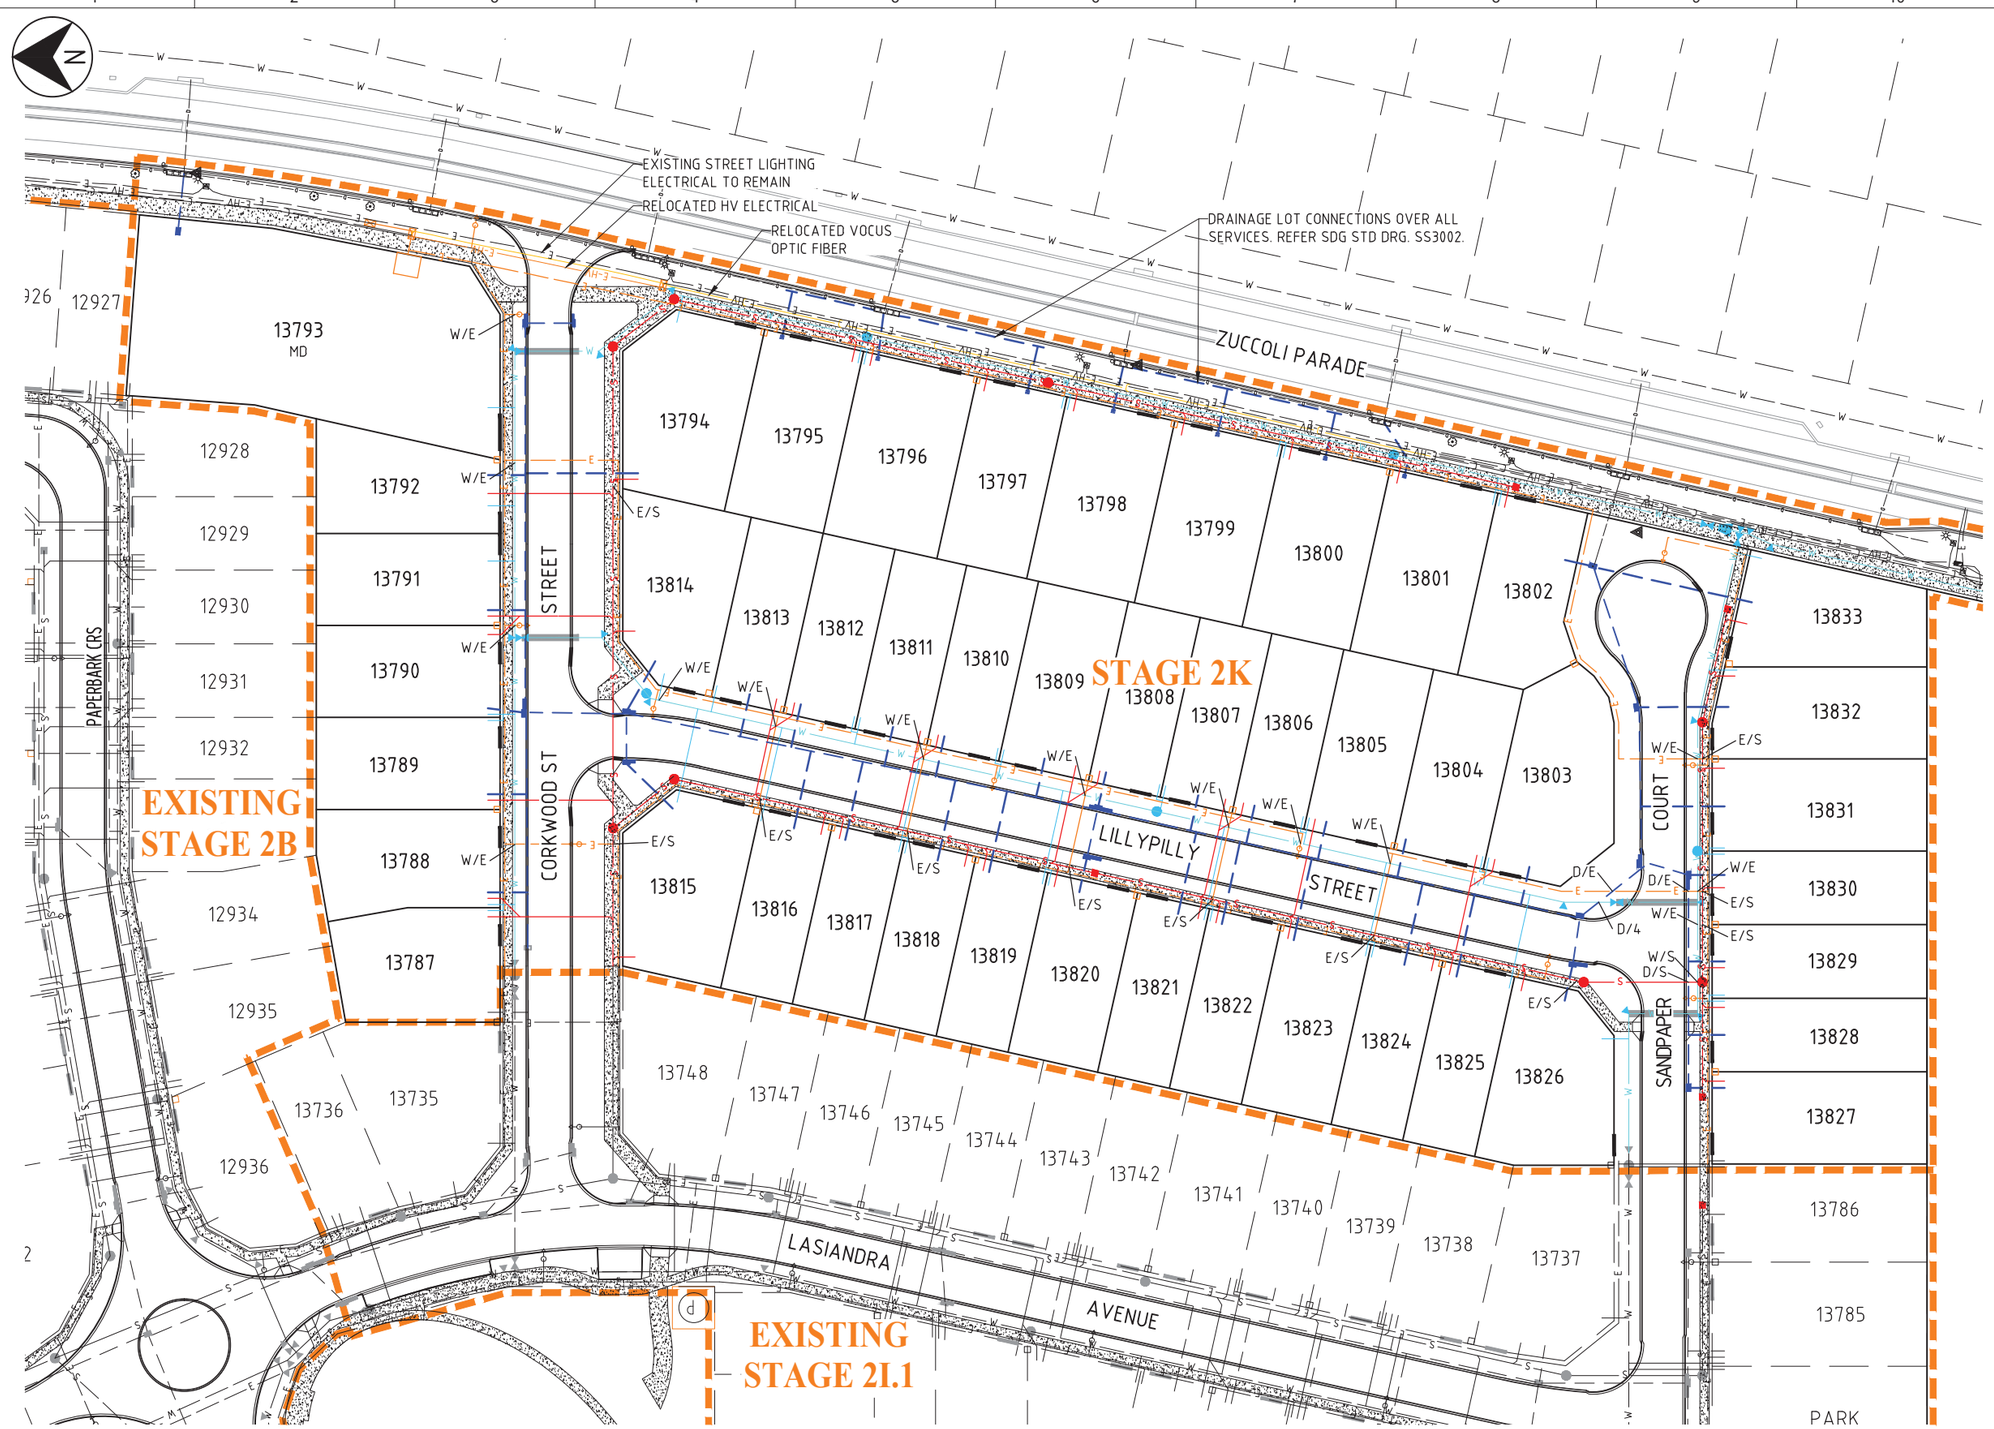

LEGEND

	STORMWATER DRAINAGE
	WATER RETICULATION
	SEWERAGE
	ELECTRICAL
	COMMUNICATIONS (NBN)
	DRIVEWAY LOCATION
W/S	WATER OVER SEWER
W/D	WATER OVER DRAINAGE
W/E	WATER OVER ELECTRICAL
S/D	SEWER OVER DRAINAGE
D/S	DRAINAGE OVER SEWER
E/D	ELECTRICAL OVER DRAINAGE
E/S	ELECTRICAL OVER SEWER
D/W	DRAINAGE OVER WATER
D/E	DRAINAGE OVER ELECTRICAL

NOTES

1. REFER DRAINAGE AND SEWER LONGITUDINAL SECTIONS FOR FURTHER DETAILS OF SERVICE CROSSINGS.

AS CONSTRUCTED INFORMATION CERTIFIED BY AKJ SERVICES

SIGNED DAVID WARD DATE 15/11/24

WARNING

BEWARE OF SERVICES

The locations of all existing services are approximate only and their exact position should be proven on site. No guarantee is given that all existing services are shown.

PERMISSION TO USE FOR CONSTRUCTION PURPOSES ONLY

SIGNED AKHIL AJITH DATE 28.09.23

ON BEHALF OF WATER SERVICES FOR THE INCORPORATION INTO POWER AND WATER CORPORATION'S NETWORK.

This permission to Use this Approved Design is given on the basis that the developer and/or Consultant is not absolved from full responsibility for the correctness and accuracy of the design and/or documents so associated.

This drawing is valid for 2 years from the date of signing.

PERMISSION TO USE FOR CONSTRUCTION PURPOSES ROADWORKS AND STORMWATER DRAINAGE.

SIGNED NADINE NILON DATE 23.01.24

DIRECTOR OF CITY GROWTH AND OPERATIONS
CITY OF PALMERSTON

This permission to use is given on the basis that the Developer and/or Consultant is not absolved from full responsibility for the correctness and accuracy of the design and/or documents associated. This permission is valid for a period of two years from the date of signed approval.

SCALE 1:500 (A1)
1:1000 (A3)

0 10 20 30 40 50m
10 8 6 4 2

AS CONSTRUCTED

REV	DATE	DRAWN	REV'D	APP'D	REVISION
1	15.11.24	TAB	TG	RK	AS CONSTRUCTED
0	30.01.24	TAB	TG	RK	ISSUED FOR CONSTRUCTION

Mitchell Creek Green
Zuccoli II

TerritoryLife

JACOBS
ABN 37 001 024 095 and ACN 001 024 095
Jacobs Group (Australia) Pty Ltd
Level 2, 23-25 Parap Road
Parap, DARWIN, NT 0820
AUSTRALIA
Tel: +61 8 8982 4800
Fax: +61 8 8982 4840
Web: www.jacobsskm.com

CLIENT TERRITORY LIFE
PROJECT MITCHELL CREEK GREEN STAGE 2K

DRAWN	DRAWING CHECK	REVIEWED	APPROVED
TAB	TG	T.GAETAN	R.KRAKE
DESIGNED	DESIGN REVIEW		
TAB	RK	DATE 07.03.23	DATE 07.03.23

TITLE
MASTER SERVICES PLAN

SCALE	DRAWING No	POWER WATER CORP. No	REV
AS SHOWN	IW178402-00-CI-DRG-0229	B23-8722	1

A1

DATE: 29/11/2024 3:17:33 PM LOGIN NAME:
LOCATION: C:\Users\gaetant\AppData\Local\projectwise\jacobs_anz_ie\d0449094\IW178402-0000-CI-DRG-0229.dwg