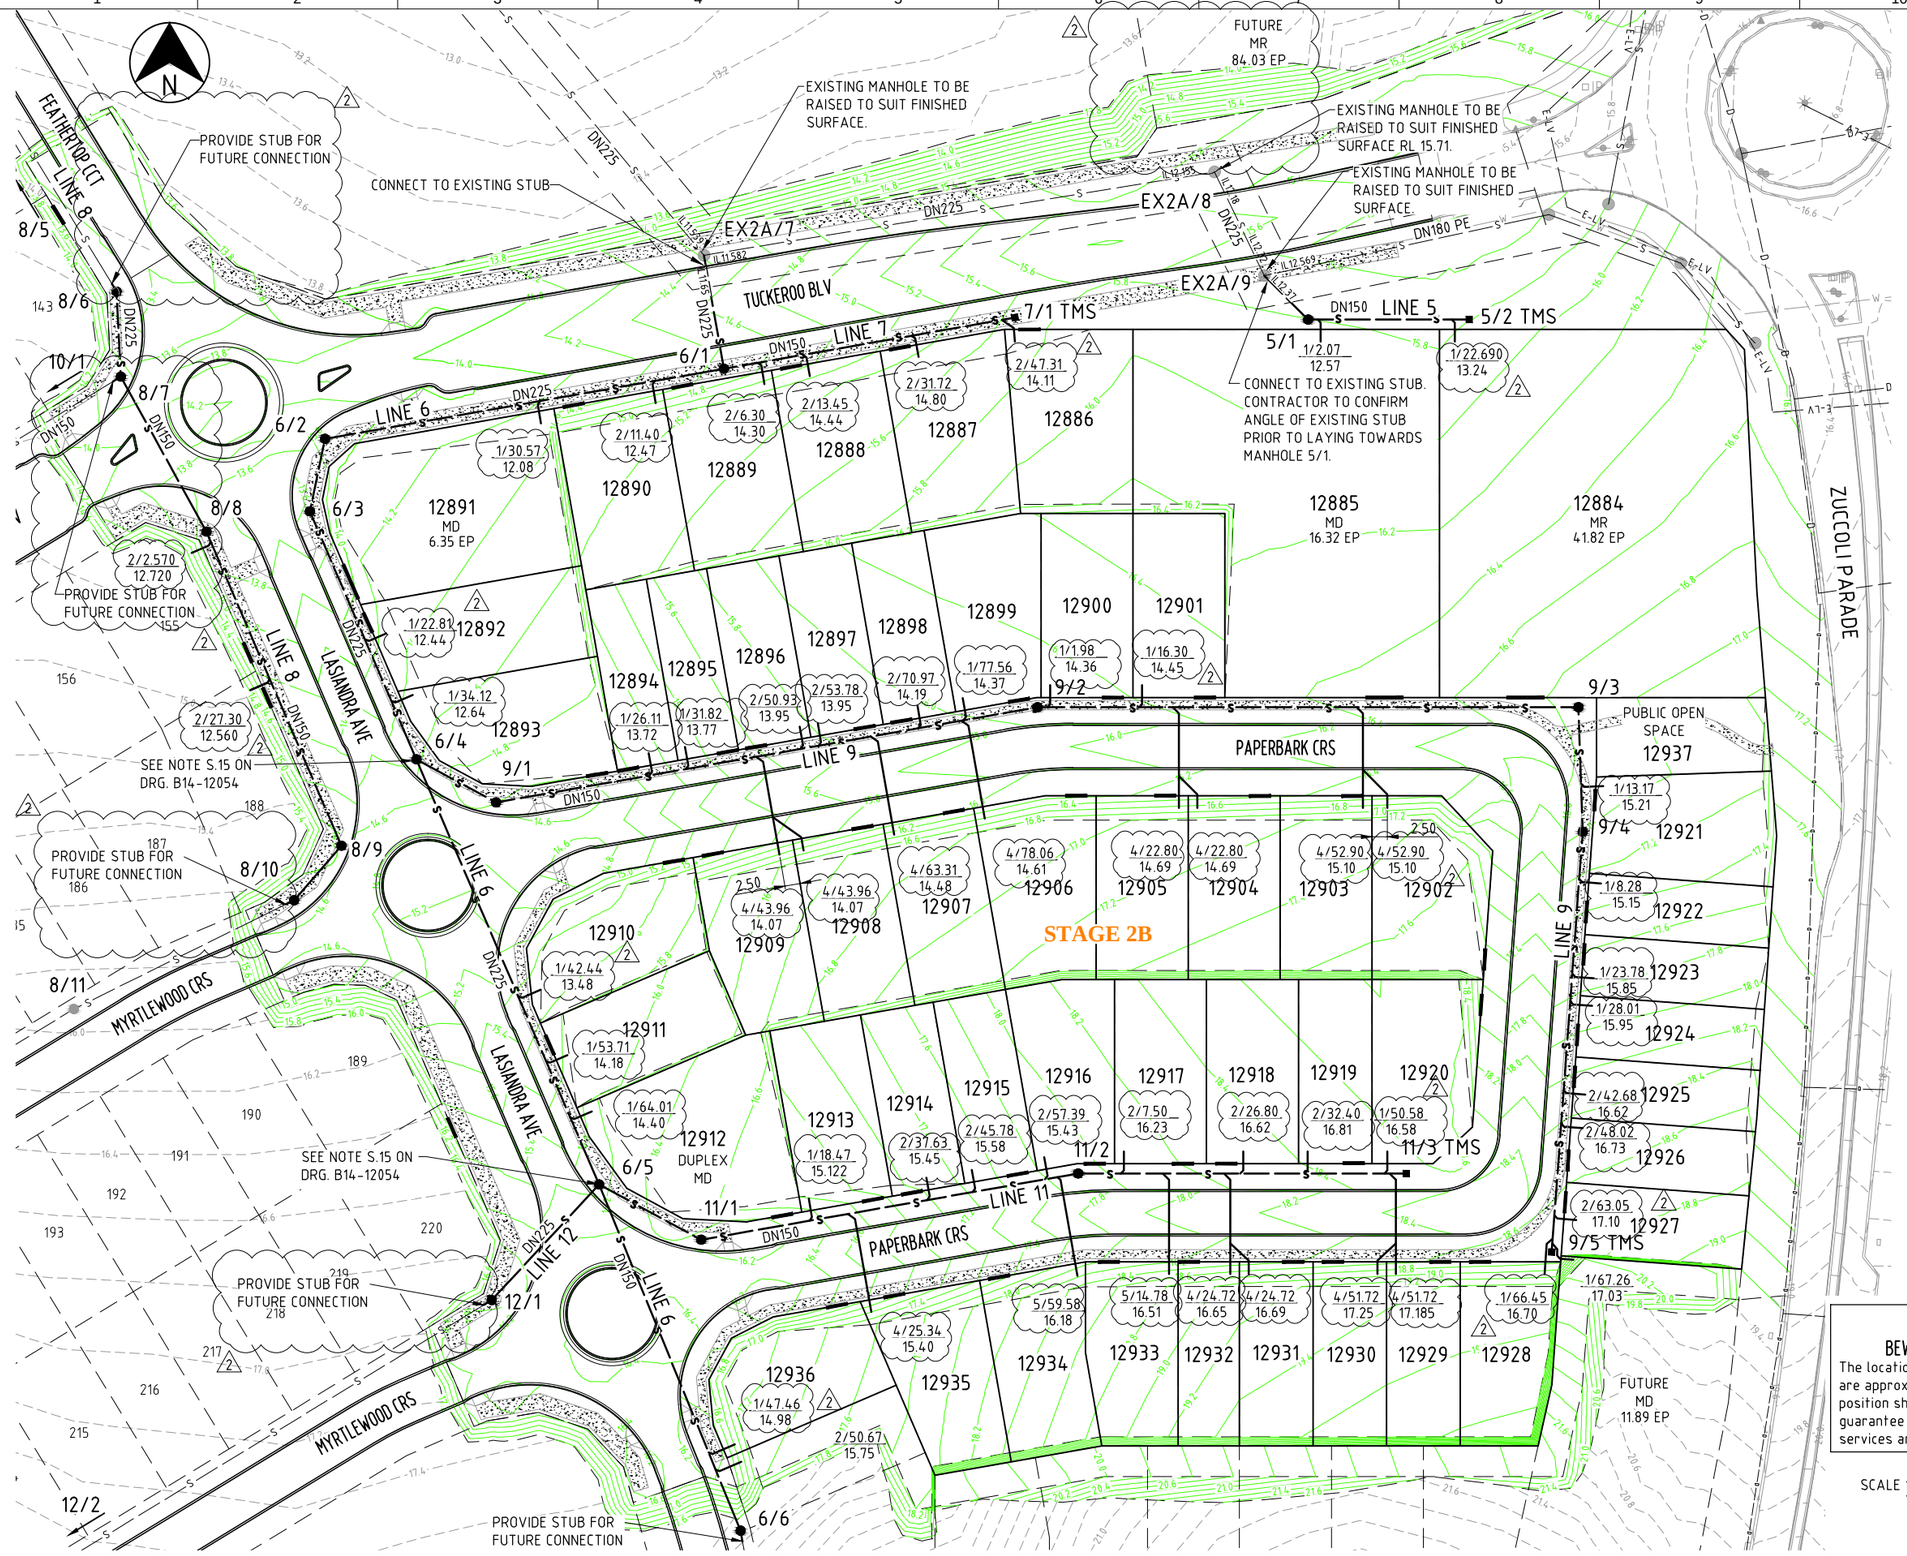

LEGEND

- SEWERAGE / CONNECTION
- SEWER ACCESS CHAMBER
- MAINTENANCE SHAFT
- DESIGN SURFACE CONTOURS (0.2m INTERVAL)
- EXISTING SURFACE CONTOURS (0.2m INTERVAL)
- EXISTING STORMWATER DRAINAGE
- EXISTING HIGH VOLTAGE ELECTRICAL
- EXISTING LOW VOLTAGE ELECTRICAL
- EXISTING SEWERAGE
- EXISTING WATER RETICULATION

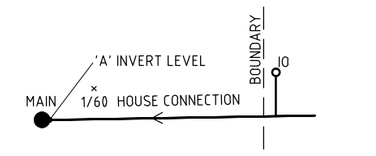

TYPE 1, TYPE 4

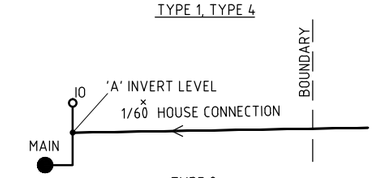

TYPE 2

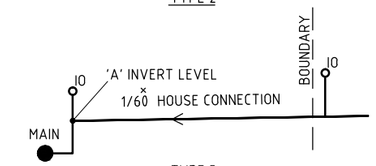

TYPE 5

TYPICAL ELEVATIONS TYPE 1, 2, 4 & 5 CONNECTION DETAILS

N.T.S.

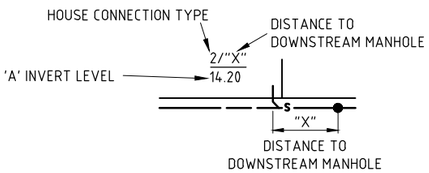

TYPICAL LOT CONNECTION SETOUT DETAIL

N.T.S.

WARNING

BEWARE OF SERVICES

The locations of all existing services are approximate only and their exact position should be proven on site. No guarantee is given that all existing services are shown.

AS CONSTRUCTED INFORMATION CERTIFIED BY BRIERTY PTY LTD

SCALE 1:500 (A1)
1:1000 (A3)

0 10 20 30 40 50m

AS CONSTRUCTED

REV	DATE	DRAWN	REV'D	APP'D	REVISION
2	30.04.15	GAC	RJB	LM	AS CONSTRUCTED
1	07.01.15	TAB	RJB	LM	LINES 8 & 10 REVISED
0	02.12.14	JAH	RJB	LM	ISSUED FOR CONSTRUCTION

Mitchell Creek Green
Zuccoli II

TerritoryLife

JACOBS
ABN 37 001 024 095 and ACN 001 024 095
Jacobs Group (Australia) Pty Ltd
Level 2, 23-25 Parap Road
Parap, DARWIN, NT 0820
AUSTRALIA
Tel: +61 8 8982 4800
Fax: +61 8 8982 4840
Web: www.jacobsskm.com

CLIENT	TERRITORY LIFE
PROJECT	MITCHELL CREEK GREEN STAGE 2B
DRAWN	JAH
DRAWING CHECK	RJB
REVIEWED	L.MUIR
APPROVED	D.CAMERON
DESIGNED	RJB
DESIGN REVIEW	LM
DATE	2/12/2014
DATE	2/12/2014

TITLE	SEWERAGE RETICULATION PLAN
SCALE	AS SHOWN
DRAWING No	DB05941.200-ECC-DG-0032
POWER WATER CORP. No	B14-12057
REV	2

DATE: 8/05/2015 10:22:18 AM LOGIN NAME:
LOCATION: C:\Users\JHaydon\AppData\Local\Jacobs\Projectwise\dalwin_projects\dms\30475\DB05941.200-ECC-DG-0032.dwg